

**SURVEY & REMONUMENTATION**

**MAR 19 1998**

**1997 Newaygo County Remonumentation Project**

**NEWAYGO COUNTY REGISTER OF DEEDS LINDA M. BROWN**

**LAND CORNER RECORDATION CERTIFICATE FILING REQUIREMENT of Act 74, Mich. P.A. 1970**

**'98 MAR 6 PM 12 34**

*Linda M. Brown*

**VOL. 2**

**60**

**SECTION**

For corners in <u>Newaygo</u> (County)	Located in:	Corner Code #
1. Public Land Survey	T <u>11N</u> R <u>14W</u>	<u>D-5</u>
	T <u>   </u> R <u>   </u>	<u>   </u>
	T <u>   </u> R <u>   </u>	<u>   </u>
	T <u>   </u> R <u>   </u>	<u>   </u>
2. Property Controlling in Section	S <u>   </u> T <u>   </u> R <u>   </u>	<u>   </u>
	S <u>   </u> T <u>   </u> R <u>   </u>	<u>   </u>
3. Miscellaneous Property in Sec.	S <u>   </u> T <u>   </u> R <u>   </u>	<u>   </u>
	S <u>   </u> T <u>   </u> R <u>   </u>	<u>   </u>
4. Lot No. _____, Recorded Plat _____		
5. Private Claims _____		

**Register of Deeds Stamp & File Number**

	A	B	C	D	E	F	G	H	I	J	K	L	M
1													
2	6	5	4	3	2	1							
3													
4	7	8	9	10	11	12							
5													
6	18	17	16	15	14	13							
7													
8	19	20	21	22	23	24							
9													
10	30	29	28	27	26	25							
11													
12	31	32	33	34	35	36							
13													

I, Norman L. Ochs, in a field survey on July 28, 1997, do hereby certify that under requirements of P. A. 74, Michigan P.A. of 1970, the corner points mentioned in lines 1 and 2 above were in conformance with regulations and rules therefore as required in the current manual of survey instructions of the United States Department of the Interior, Bureau of Land Management or by a decree of a Court of Law and/or that the corner points mentioned in lines 3, 4 and 5 above were in conformance with the rules of the Michigan Board of Land Surveyors or by a Decree of a Court of Law; established, re-established, monumented, re-monumented, recovered, found as expressed below:

**Note: Not more than 4 corners, all in the same town and range, may be recorded on this certificate.**

South One Quarter Corner, Section 8, Bridgeton Township, Newaygo County, Michigan.

**A. DESCRIPTION OF ORIGINAL MONUMENT AND ACCESSORIES AND/OR SUBSEQUENT RESTORATION:**

G.L.O. John Mullett 1837  
12" Beech S46°E 21 Links (13.86') #1  
12" Beech N78°W 22 Links (14.52') #2

Ralph A. Smith R.L.S. #3421  
Book 56 Page 46 and Witness Book Number 2 Page 132  
1951 Found Gas Pipe  
16" White Oak N45°W 115.1' #3  
14" Cherry N60°W 67.7' #4  
Telephone Pole S65°E 76.3' #5  
10" Cherry N02°E 30.9' #6

Newaygo County Road Commission Sheet  
1 1/2" Pipe  
Telephone Pole S65°E 76.3' #5  
10" Twin Cherry N02°E 30.9' #6  
10" Twin Cherry N46°E 43.7' #7

Newaygo Engineering and Survey Company  
September 29, 1979 Recorded in Series K Number 2530 Found 1/2" Rod  
12" Forked Cherry N02°E 30.85' #6  
12"-12" Twin Cherry N46°E 43.58' #7  
14"-14"-14" Triple Cherry S20°E 133.96' #8

**OVER ↘**

**B. DESCRIPTION OF CORNER EVIDENCE FOUND AND/OR METHOD APPLIED IN RESTORING OR REESTABLISHING CORNER:**

Found 1/2" rod over 1 1/2" Pipe 2.3 feet long in centerline of East and West road and centerline of gravel road going South is 2 feet West and the condition of the recorded witnesses are: #1 and #2 gone, #3 and #4 good condition, #5 gone, #6 thru #9 good condition.

**C. DESCRIPTION OF MONUMENT FOR CORNER AND ACCESSORIES ESTABLISHED TO PERPETUATE LOCATING THE POSITION OF THE CORNER:**

Replaced 1/2" rod and 1 1/2" Pipe with 4" diameter Harrison cast iron monument 20" long marked "County Surveyor" as a substantial marker for the section corner and is accepted as a careful and faithful reestablishment of the original corner.

30" White Oak N41°W 115.76' Set spike and tag in Southwest side of tree. #3  
32" Cherry N60°W 68.12' Found spike in South side of tree. #4  
14" Cherry N07°E 31.44' Found spike in East side of tree. #6  
26" Cherry N50°E 44.53' Found spike in Southeast side of tree. #7  
22"-20"-16" Triple Cherry Stump S03°E 133.88' Found spike and tag in West stump. #8  
18" White Pine N03°E 46.23' Set nail in East side of tree. #9

Signed by Norman L. Ochs Date September 8, 1997


Surveyor's Michigan License No. 22439

Form approved by Michigan State Board of Land Surveyors, Jan 28, 1971

Revised May 14, 1975  
Revised Jan., 1983

Approved by Peer Review Group on September 9, 1997  
Norman L. Ochs, County Representative.

*N.L.O.*

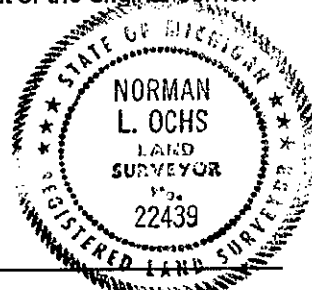

A. Description (cont.)

Paul E. Van Kooten R.L.S. #8618

November 1979 LCRC #505

Found 1/2" Rod

34" Wild Cherry Northwest 68.17' #4

14" Twin White Cherry Northeast 44.22' #7

10" Pine North 46.23' #9