

SURVEY & REMONUMENTATION

MAR 19 1998

1997 Newaygo County Remonumentation Project

**LAND CORNER RECORDATION CERTIFICATE
FILING REQUIREMENT of Act 74, Mich. P.A. 1970**

NEWAYGO COUNTY
REGISTER OF DEEDS
LINDA M. BROWN

'98 MAR 6 PM 12 34

SECTION

For corners in <u>Newaygo</u> (County)	Located in:	Corner Code #
1. Public Land Survey	<u>T 11N R14W</u>	<u>F-5</u>
	T <u> </u> R <u> </u>	<u> </u>
	T <u> </u> R <u> </u>	<u> </u>
	T <u> </u> R <u> </u>	<u> </u>
2. Property Controlling in Section	S <u> </u> T <u> </u> R <u> </u>	<u> </u>
	S <u> </u> T <u> </u> R <u> </u>	<u> </u>
3. Miscellaneous Property in Sec.	S <u> </u> T <u> </u> R <u> </u>	<u> </u>
	S <u> </u> T <u> </u> R <u> </u>	<u> </u>
4. Lot No. _____, Recorded Plat _____		
5. Private Claims _____		

Linda M. Brown

VOL. 2

62

Register of Deeds Stamp & File Number

	A	B	C	D	E	F	G	H	I	J	K	L	M
1													
2	6		5		4		3		2		1		
3													
4	7		8		9		10		11		12		
5													
6	18		17		16		15		14		13		
7													
8	19		20		21		22		23		24		
9													
10	30		29		28		27		26		25		
11													
12	31		32		33		34		35		36		
13													

I, Norman L. Ochs, in a field survey on July 3, 1997, do hereby certify that under requirements of P. A. 74, Michigan P.A. of 1970, the corner points mentioned in lines 1 and 2 above were in conformance with regulations and rules therefore as required in the current manual of survey instructions of the United States Department of the Interior, Bureau of Land Management or by a decree of a Court of Law and/or that the corner points mentioned in lines 3, 4 and 5 above were in conformance with the rules of the Michigan Board of Land Surveyors or by a Decree of a Court of Law; established, re-established, monumented, re-monumented, recovered, found as expressed below:

Note: Not more than 4 corners, all in the same town and range, may be recorded on this certificate.

North One Quarter Corner, Section 16, Bridgeton Township, Newaygo County, Michigan

A. DESCRIPTION OF ORIGINAL MONUMENT AND ACCESSORIES AND/OR SUBSEQUENT RESTORATION:

- | | |
|---|---|
| G.L.O. John Mullett 1837
12" Hemlock S55°W 17 Links (11.22')#1
12" Hemlock N65°E 8 Links (5.28')#2 | Newaygo County Road Commission Sheet
Iron
Pine Stump Northwest 55.0' #4
Telephone Pole Northeast 41.10' #6
Pine Stump Southeast 42.10' #7 |
| Ralph A. Smith R.L.S. #3421
Lyle S. Shepherd's Witness Book Number 2 Page 132
September 8, 1961 Found 1 1/4" Gas Pipe
Power Pole N75°E 65.0' #3
10" Pine N20°W 55.7' #4
30" Maple S70°E 106.17' #5 | Patrick A. Salisbury R.L.S. #13594
March 12, 1975 "Grasshopper Flats"
Recorded in Liber 10 of plats, Page 3
Northeast Corner of Plat |
| Newaygo Engineering and Survey Company
Drawing Number 82031AC July 13, 1982
Found 1/2" rod
Pine Stump Northwest 55.0' #4
Telephone Pole Northeast 41.10' #6 | Paul E. Van Kooten R.L.S. #8618
Found 1/2" Rod L.C.R.C. #504 March 11, 1980
Power Pole Northwest 50.85' p.k. in Northeast side of pole. #8
Power Pole Northeast 65.28' p.k. in Northerly side of pole. #3
34" Maple East - Southeast 107.10' Square spike in North side of tree. #5 |

B. DESCRIPTION OF CORNER EVIDENCE FOUND AND/OR METHOD APPLIED IN RESTORING OR REESTABLISHING CORNER:


Found 3/4" X 1 1/4" solid bar, 1 1/2" X 24" Iron pipe slid over bar and 1/2" rerod inside of 1 1/2" pipe and the centerline of the North and South bituminous road is 4.5 feet East and in the centerline of East and West road. The condition of the recorded witnesses are: #1 and #2 gone, #3 good condition, #4 gone, #5 good condition, #6 and #7 gone, #8 good condition.

C. DESCRIPTION OF MONUMENT FOR CORNER AND ACCESSORIES ESTABLISHED TO PERPETUATE LOCATING THE POSITION OF THE CORNER:

Removed 3/4" X 1 1/4" solid bar, 1 1/2" X 24" iron pipe, and 1/2" rerod, 1 1/2" pipe and set a 4" diameter Harrison cast iron monument 20" long marked "County Surveyor" as a substantial marker for the section corner and is accepted as a careful and faithful reestablishment of the original corner.

- Power Pole N69°E 65.29' Found P.K. in North side of pole. #3
- 42" Maple S63°E 107.10' Set spike with tag in North side of tree. #5
- Power Pole N48°W 50.55' Found Consumer's Power Company tag in Northeast side of pole. #8
- 14" Red Pine N02°W 109.91' Set spike and tag in West side of tree.

Signed by Norman L. Ochs Date September 8, 1997
Surveyor's Michigan License No. 22439

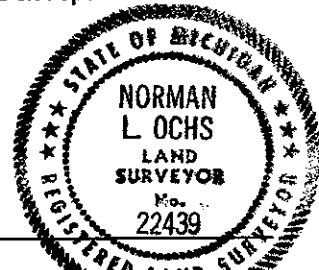

Approved by Peer Review Group on September 9, 1997
Norman L. Ochs, County Representative.

Form approved by Michigan State Board of Land Surveyors Jan 23, 1997
Revised May 14, 1975
Revised Jan., 1983

N.L.O.