

**SURVEY &
REMONUMENTATION**

1995 Newaygo County Remonumentation Project

APR 04 1996

LAND CORNER RECORDATION CERTIFICATE
FILING REQUIREMENT of Act 74, Mich. P.A. 1970

NEWAYGO COUNTY,
REGISTER OF DEEDS
MARLEY TOWER

COMMISSION

For corners in
Newaygo
(County)

Located in:

Corner Code #

96 FEB 21 AM 9 38

- 1. Public Land Survey T 11N R 14W I-2
- T _____ R _____
- T _____ R _____
- T _____ R _____
- 2. Property Controlling S _____ T _____ R _____
- in Section S _____ T _____ R _____
- 3. Miscellaneous S _____ T _____ R _____
- Property in Sec. S _____ T _____ R _____
- 4. Lot No. _____, Recorded Plat _____
- 5. Private Claims _____

Matthew T. ...
VOL. 1 PAGE 162

Register of Deeds Stamp & File Number

I, Norman L. Ochs, in a field survey on September 23, 1995, do hereby certify that under requirements of P. A. 74, Michigan P.A. of 1970, the corner points mentioned in lines 1 and 2 above were in conformance with regulations and rules therefore as required in the current manual of survey instructions of the United States Department of the Interior, Bureau of Land Management or by a decree of a Court of Law and/or that the corner points mentioned in lines 3, 4 and 5 above were in conformance with the rules of the Michigan Board of Land Surveyors or by a Decree of a Court of Law; established, re-established, monumented, re-monumented, recovered, found as expressed below:

	A	B	C	D	E	F	G	H	I	J	K	L	M
2	6		5		4		3		2		1		
3													
4	7		8		9		10		11		12		
5													
6	18		17		16		15		14		13		
7													
8	19		20		21		22		23		24		
9													
10	30		29		28		27		26		25		
11													
12	31		32		33		34		35		36		
13													

Note: Not more than 4 corners, all in the same town and range, may be recorded on this certificate.

E 1/4 corner, Section 3, Bridgeton Twp., Newaygo Co., MI

A. DESCRIPTION OF ORIGINAL MONUMENT AND ACCESSORIES AND/OR SUBSEQUENT RESTORATION:

- G.L.O. John Mullett 1837
18" Hemlock (corner)
- William M. Jacques (Co. Surveyor)
Book B Pg's 2 & 3 and Book 14 Pg's 49 & 50 November 15, 1904
Pine root stake
Established at proportional measurement
Measured 38.05 ch (2511.30 ft) from the NE cor. to the E 1/4 cor. of Sec. 3 and measured 39 ch (2574 ft) from the W 1/4 cor. to the SE cor. of Sec. 3
- Phillip A. Harrison
Late 1800's Book A Pg. 29
15" Hemlock S69°E 67Lks (44.22') #1
25" Hemlock S28°30'E 43Lks (28.38') #2
- Newaygo Engineering and Survey Co. 1978
Found 3/8" Iron
- In Lye S. Shepherd RLS #503
Witness Book No. 2 Pg. 134 By Unknown Assistant
3/4" Pipe
28" W. Oak S02°E 34.24' #3
18" Maple S50°W 42.68' #4
SW cor. hse. N53°E 142.35' #5
- William Fries Jr. RLS #30389 August 21, 1991
Set 1/2" Rod and cap LCRC #1136
Using Witness by the Newaygo County Road Commission
10"-6"-9" Apple AZ13° 113.51' #6
24" Oak AZ186° 34.29' #7
19" Maple AZ235° 42.68' #4
P. Pole AZ330° 56.26' #8

OVER ↘

B. DESCRIPTION OF CORNER EVIDENCE FOUND AND/OR METHOD APPLIED IN RESTORING OR REESTABLISHING CORNER:

Found 1/2" rod and cap by William Fries, Jr. P.S. #30389 and found old rotted wood and piece of 2" pipe in hole lying flat and measured 5199.43 ft from the W. 1/4 Cor. to the E. 1/4 Cor. of Sec. 3 and measured 2605.03 ft from the C. 1/4 Cor. to the E. 1/4 Cor. of Sec. 3 and measured 2673.81 ft from the W. 1/4 Cor. to the C. 1/4 Cor. of Sec. 2 and the centerline of the East and West road is 3 ft North and the condition of the recorded witnesses are: #1 and #2 gone, #3 thru #6 good condition, #7 gone, #8 good condition.

C. DESCRIPTION OF MONUMENT FOR CORNER AND ACCESSORIES ESTABLISHED TO PERPETUATE LOCATING THE POSITION OF THE CORNER:

Removed 1/2" rod and cap and set a 4" dia. Harrison cast iron monument 20" long marked "County Surveyor" as a substantial marker for the section corner and is a careful and faithful reestablishment of the original corner.


- 36" W. Oak S02°E 33.82' #3
- 26" Maple S50°W 42.88' #4
- Fd. broken conc. fndtn. N53°E 142.75' #5
- 10"-6"-9" Apple N13°E 114.02' #6
- P. Pole N30°W 56.33' #8
- N.W. Corner of barn fndtn. S69°E 142.50'

Signed by Norman L. Ochs Date October 2, 1995

Norman L. Ochs

Surveyor's Michigan License No. 22439

Form approved by Michigan State Board of Land Surveyors, dated 1971
Revised May 14, 1975
Revised Jan., 1983

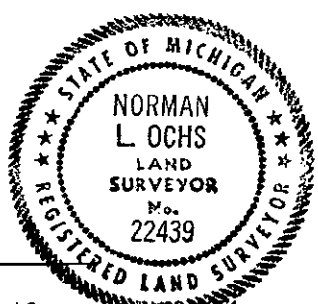

Approved by Peer Review Group On December 13, 1995
Norman L. Ochs, County Representative.

Norman L. Ochs

A. Description ... (Continued)

NCRC

3/4" Sq. Iron

28" W. Oak S02°E34.24' #3

18" Maple S50°W 42.68' #4

S.W. Cor. Hse. N53°E 142.35' #5

Measured 2599.2 ft from the C. 1/4 Cor. to the E. 1/4 Cor. of Sec. 3 and measured 2674.05 ft from the W. 1/4 Cor. to the C. 1/4 Cor. of Sec. 2.

W.A. DeVette May 28, 1969

Measured 2666.20 ft from the E. 1/4 Cor. to the S.E. Cor. of Sec. 3 and measured 2674.30 ft from the W. 1/4 Cor. to the C. 1/4 Cor. of Sec. 2.