

MAR 02 1999

1998 Newaygo County Remonumentation

NEWAYGO COUNTY REGISTER OF DEEDS LINDA M. BROWN

'99 FEB 17 PM 3 33

SECTION

LAND CORNER RECORDATION CERTIFICATE FILING REQUIREMENT of Act 74, Mich. P.A. 1970

Linda M. Brown

For corners in Newaygo (County) Located in: Corner Code # 1. Public Land Survey T 11N R 14W K-1 2. Property Controlling in Section S T R 3. Miscellaneous Property in Sec. S T R 4. Lot No. , Recorded Plat 5. Private Claims

VOL. 2

156

Register of Deeds Stamp & File Number

Grid table with columns A-M and rows 1-13. Cell (1, J) is shaded.

I, Norman L. Ochs, in a field survey on January 7, 1998, do hereby certify that under requirements of P. A. 74, Michigan P.A. of 1970, the corner points mentioned in lines 1 and 2 above were in conformance with regulations and rules therefore as required in the current manual of survey instructions of the United States Department of the Interior, Bureau of Land Management or by a decree of a Court of Law and/or that the corner points mentioned in lines 3, 4 and 5 above were in conformance with the rules of the Michigan Board of Land Surveyors or by a Decree of a Court of Law; established, re-established, monumented, re-monumented, recovered, found as expressed below:

Note: Not more than 4 corners, all in the same town and range, may be recorded on this certificate.

Northeast Corner, Section 2, Bridgeton Township, Newaygo County, Michigan.

A. DESCRIPTION OF ORIGINAL MONUMENT AND ACCESSORIES AND/OR SUBSEQUENT RESTORATION:

G.L.O. N. Brookfield 1838 12" Beech S18°W 25 Links (16.5') #1 18" Hemlock S58°E 19 Links (12.54') #2 Patrick A. Salisbury R.L.S. #13594 December 14, 1971 Found 1/2" Rod Telephone Pole S25°W 63.10' #5 Power Pole N45°W 106.18' #3 18" Twin Maple S30°E 62.36' #4 Southeast Corner, Section 35, T12N R14W, East 32.90' #8 Lyle S. Shepherd R.L.S. #503 Witness Book Number 2 Page 123 Iron Consumers Power Company Pole N45°±W 105.9' #3 8" Twin Maple S35°±E 62.5' #4 Norman L. Ochs R.L.S. #22439 1978 Found 1/2" Rod Telephone Pole S37°W 62.52' #5 Power Pole N50°W 106.14' #3 18" Twin Maple S30°E 62.35' #4 OVER

B. DESCRIPTION OF CORNER EVIDENCE FOUND AND/OR METHOD APPLIED IN RESTORING OR REESTABLISHING CORNER:

Found 3/4" Rod. The centerline of the North and South bituminous road is 22 feet West and the centerline of the gravel road going East is 3 feet South and the centerline of bituminous road going West is 3 feet South. The condition of the recorded witnesses are: #1 thru #3 gone, #4 stump, #5 and #6 gone, #7 and #8 good condition.

C. DESCRIPTION OF MONUMENT FOR CORNER AND ACCESSORIES ESTABLISHED TO PERPETUATE LOCATING THE POSITION OF THE CORNER:

Removed 3/4" Rod and set a 2 3/4" diameter Harrison cast iron monument 20" long marked "County Survey" in monument box as a substantial marker for the section corner and is accepted as a careful and faithful reestablishment of the original corner.


Property Iron N20°W 52.0' #7 1" Rod, Southeast Corner, Section 35, T11N R14W, East 33.08' #8 Northwest Corner School S08°E 78.55' 16" Ash S23°E 42.85' Set spike and tag in Northeast side of tree. Power Pole N56°W 133.92' Found spike in Northeast side of pole. 10" to 5" Clump Maple S84°W 178.67' Set spike and tag in Southeast side of tree.

Signed by Norman L. Ochs Date November 5, 1998

Surveyor's Michigan License No. 22439 Form approved by Michigan State Board of Land Surveyors, 1971

Approved by Peer Review Group on December 22, 1998 Norman L. Ochs, County Representative.

Revised May 14, 1975 Revised Jan., 1983

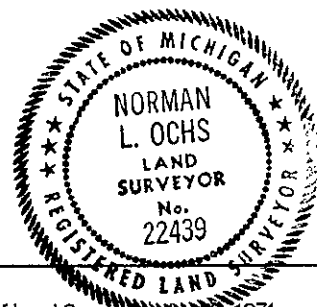

M.L.O.

A. Description (cont.)

Charles E. Fricke R.L.S. #21781  
Point is 0.4' North of  $\frac{3}{4}$ " Iron  
12" Ash S55°E 65.7' #6  
Power Pole N55°W 106.0' #3  
18" Maple S30°E 62.9' #4  
Property Iron N20°W 52.0' #7

SURVEY &  
REMONUMENTATION

MAR 02 1999

SECTION