

**SURVEY & REMONUMENTATION**

MAR 19 1998

**1997 Newaygo County Remonumentation Project**

NEWAYGO COUNTY  
REGISTER OF DEEDS  
LINDA K. BROWN

**SECTION**

**LAND CORNER RECORDATION CERTIFICATE  
FILING REQUIREMENT of Act 74, Mich. P.A. 1970**

'98 MAR 6 PM 12 35

*Linda M. Brown*

For corners in Newaygo (County)	Located in:	Corner Code #
1. Public Land Survey	T 12N R 12W	G-7
	T ___ R ___	_____
	T ___ R ___	_____
	T ___ R ___	_____
2. Property Controlling In Section	S ___ T ___ R ___	_____
	S ___ T ___ R ___	_____
3. Miscellaneous Property in Sec.	S ___ T ___ R ___	_____
	S ___ T ___ R ___	_____
4. Lot No. _____, Recorded Plat _____		
5. Private Claims _____		

VOL. 2

82

Register of Deeds Stamp & File Number

	A	B	C	D	E	F	G	H	I	J	K	L	M
1													
2	6	5	4	3	2	1							
3													
4	7	8	9	10	11	12							
5													
6	18	17	16	15	14	13							
7													
8	19	20	21	22	23	24							
9													
10	30	29	28	27	26	25							
11													
12	31	32	33	34	35	36							
13													

I, Norman L. Ochs, in a field survey on July 31, 1997, do hereby certify that under requirements of P. A. 74, Michigan P.A. of 1970, the corner points mentioned in lines 1 and 2 above were in conformance with regulations and rules therefore as required in the current manual of survey instructions of the United States Department of the Interior, Bureau of Land Management or by a decree of a Court of Law and/or that the corner points mentioned in lines 3, 4 and 5 above were in conformance with the rules of the Michigan Board of Land Surveyors or by a Decree of a Court of Law, established, re-established, monumented, re-monumented, recovered, found as expressed below:

**Note: Not more than 4 corners, all in the same town and range, may be recorded on this certificate.**

Southeast Corner, Section 16, Brooks Township, Newaygo County, Michigan

**A. DESCRIPTION OF ORIGINAL MONUMENT AND ACCESSORIES AND/OR SUBSEQUENT RESTORATION:**

G.L.O. J.H. Mullett 1839  
10" Black Oak S62°E 36 Links (23.76') #1  
8" Black Oak N73°W 41 Links (27.06') #2

Lyle S. Shepherd R.L.S. #503  
Book 71 Pages 116 and 117 November 1, 1937  
12" Black Oak S42°45'E 28.2' #3  
8" Black Oak S36°W 30.9' #4

Newaygo County Road Commission Sheet  
10" Oak S45°W 30.8' #5  
14" Oak S25°E 28.40' #6

Lyle S. Shepherd R.L.S. #503  
Book 71 page 116 November 1, 1939  
1" Iron  
12" Oak S45°W 30.4' #4  
18" Oak S25°E 27.9' #3

Lyle S. Shepherd R.L.S. #503  
April 30, 1940 Book 71 Page 122  
Found 1" Pipe

Patrick A. Salisbury R.L.S. #13594  
March 5, 1970  
Power Pole N40°E 102.0' #5  
Telephone Pole S88°E 34.6' #6

OVER ↙

**B. DESCRIPTION OF CORNER EVIDENCE FOUND AND/OR METHOD APPLIED IN RESTORING OR REESTABLISHING CORNER:**

Found 1" rod (buggy axle) raised with 1/2" rod with stone on North side and on centerline of extension of West the road is 18 feet South of physical centerline of the road going West. The centerline of road going North is 2 feet East and the centerline of driveway going South is 3 feet West. The condition of the recorded witnesses are: #1 and #2 gone, #3 thru #5 good condition, #6 gone, #7 and #8 good condition.

**C. DESCRIPTION OF MONUMENT FOR CORNER AND ACCESSORIES ESTABLISHED TO PERPETUATE LOCATING THE POSITION OF THE CORNER:**

Removed 1" Rod (buggy axle) and 1/2" Rod and set a 4" diameter Harrison cast iron monument 20" long marked "County Surveyor" with stone on North side, as a substantial marker for the section corner and is accepted as a careful and faithful reestablishment of the original corner.

32" Black Oak S38°E 28.8' Found nail in Northeast side of tree. #3  
18" Black Oak S42°W 30.98' Found spike in Southeast side of tree. #4  
Power Pole N40°E 102.35' Face. #5  
14" Red Pine N89°E 44.74' Spike in North side of tree. #7  
28" White Pine N55°E 88.65' Spike in South side of tree. #8


Signed by Norman L. Ochs

Date September 8, 1997

Surveyor's Michigan License No. 22439

Form approved by Michigan State Board of Land Surveyors, Jan 28, 1971  
Revised May 14, 1975  
Revised Jan., 1983

Approved by Peer Review Group on September 9, 1997  
Norman L. Ochs, County Representative.

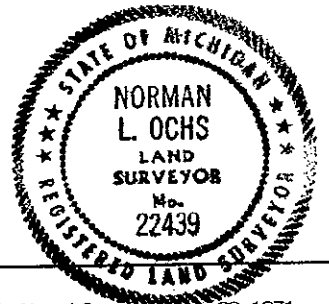

*N.L.O.*

A. Description (cont.)

James E. Evans R.L.S. #22431  
November 4, 1981 Drawing Number 81121AC  
Found ¾" Rod 3 feet long  
28" Black Oak S25°E 28.4' #3  
12" Black Oak S45°W 30.8' #4  
Power Pole N45°±E #5

Glenn A. Fauser R.L.S. #18657  
Consumers Power Company Section Break April 1983  
Drawing Number S-F 18290 FB 1355  
Found ½" Solid iron  
24" Oak S40°E 28.62' #3  
12" Oak S40°W 30.74' #4  
Red Pine N89°E 44.81' #7  
14" White Pine N55°E 88.73' #8

Carl Englert, Jr. R.L.S. #18987  
LCRC #1099 November 12, 1990  
Found 1" Pipe  
26" Oak Southeast 28.78' #3  
15" Oak Southwest 31.00' #4  
14" Red Pine East 44.75' #7  
24" White Pine Northeast 88.77' #8