

1994 NEWAYGO COUNTY REMONUMENTATION PROJECT

LAND CORNER RECORDATION CERTIFICATE  
Filing Requirement of Act 74, Mich. P.A. 1970

VOL 001 PAGE 89

For corners in Newaygo (County)


Located In:	Corner Code <del>##</del>
1. Public Land Survey T <u>12N</u> R <u>12W</u>	<u>J-3</u>
T _____ R _____	_____
T _____ R _____	_____
T _____ R _____	_____
2. Property Controlling S _____ T _____ R _____	_____
in Section S _____ T _____ R _____	_____
3. Miscellaneous S _____ T _____ R _____	_____
Property in Sec. S _____ T _____ R _____	_____
4. Lot No. _____, Recorded Plat _____	_____
5. Private Claims _____	_____

NEWAYGO COUNTY  
REGISTER OF DEEDS  
MARLENE TOOGOOD

'95 MAR 14 PM 3 53

*Marlene Toogood*  
Register of Deeds Stamp & File Number

I, Norman L. Ochs, in a field survey on September 3, 1994, do hereby certify that under requirements of P.A. 74, Michigan P.A. of 1970, the corner points mentioned in lines 1 and 2 above were in conformance with regulations and rules therefore as required in the current manual of survey instructions of the United States Department of the Interior, Bureau of Land Management or by a decree of a Court of Law and/or that the corner points mentioned in lines 3, 4 and 5 above were in conformance with the rules of the Michigan Board of Land Surveyors or by a Decree of a Court of Law, established, re-established, monumented, re-monumented, recovered, found as expressed below:

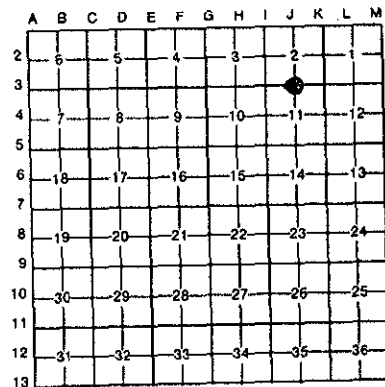

**NOTE: Not more than 4 corners, all in the same town and range, may be recorded on this certificate.**

N-1/4 Cor., Section 11, Brooks Twp., Newaygo County MI


A. Description of original monument and accessories and/or subsequent registration:  
GLO J.H. Mallett 1838  
10" B. Oak S51°E 190 lks (125.40') #1  
18" B. Oak N74°E 161 lks (106.26') #2

May 13, 1977 Newaygo Eng. & Survey Co  
Dug Found nothing. Set 3/4" pipe.  
Set 1/2 way on line from SE to the SW corners.  
30" B. Oak S40°E 45.10' #3  
20" B. Oak S62°W 64.16' #4  
14"-14" Tw. B. Oak N10°W 101.79' #5  
Conc. Mon N 33.00'  
Measured 2647.36 ft. from the NW cor to the N-1/4 cor. of Sec. 11. Measured 2637.34' from the S-1/4 cor. to the C-1/4 cor. of Sec. 2. Measured 2658.86 ft. from the N-1/4 cor. to the C-1/4 cor. of Sec. 11. Measured 2647.36 ft. from the N-1/4 cor. to the NE cor. of Sec. 11

B. Description of corner evidence found and/or method applied in restoring or reestablishing corner:  
Found 3/4" Pipe.  
Condition of witnesses are No. 1 & 2 are gone and No. 3 thru 6 are in good condition.

C. Description of monument for corner and accessories established to perpetuate locating the position of the corner:  
Removed 3/4" pipe and set a 4" dia. Harrison cast iron mon. on woods line going South and 2 ft. South of CL E & W gravel road and is accepted as a careful and faithful reestablishment of the original position of the corner.

4" x 36" Conc. Mon. with 1/2" Rod 32.98' North  
30" B. Oak S62°W 64.16' Spk. on NW side #4.  
40" B. Oak S40°E 45.12' Spk. on W side #3.  
20"-20" Tw. B. Oak N10°W 101.79' #5. Spk. on E side.

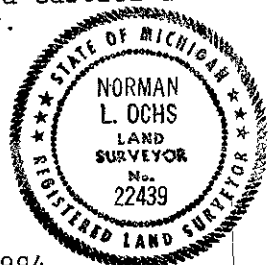

Signed by Norman L. Ochs Date October 19, 1994  
Surveyor's Michigan License No. 22439  
Approved by Peer Review Group on November 3, 1994.  
Norman L. Ochs, County Representative. *N.L.O.*

FORM APPROVED BY MICHIGAN STATE BOARD OF LAND SURVEYORS, JAN. 28, 1971  
REVISED MAY 14, 1975  
REVISED JAN., 1983

SURVEY &  
REMONUMENTATION  
DEC 07 2000  
SECTION