

# LAND CORNER RECORDATION CERTIFICATE

## FILING REQUIREMENT OF ACT 74, MICH. P.A.1970

FOR CORNERS OF--:	LOCATED IN--:	CORNER CODE NUMBER
1. PUBLIC LAND SURVEY _____	T. <u>12</u> <sup>N.</sup> <input checked="" type="radio"/> , R. <u>13</u> <sup>W.</sup> <input checked="" type="radio"/>	<u>H-11;H-12;I-11;I-12</u>
2. PROPERTY CONTROLLING IN SECTION _____	, T. _____, <sup>N.</sup> S., <sup>R.</sup> _____, <sup>E.</sup> W. _____	_____
3. MISCELLANEOUS PROPERTY IN SECTION _____	, T. _____, <sup>N.</sup> S., <sup>R.</sup> _____, <sup>E.</sup> W. _____	_____
4. LOT NO. _____, RECORDED PLAT _____		
5. PRIVATE CLAIMS _____		

REGISTER OF DEEDS STAMP AND FILING NUMBER \_\_\_\_\_

I, Carl F. Roser, do hereby certify that under requirements of P.A. 74, Michigan P.A. of 1970, the corner points mentioned in lines 1 and 2 above were, in a field survey on June 26, 1975, established, re-established, monumented, re-monumented, recovered or restored as expressed below and in conformance with regulations and rules therefore as required in the current manual of survey instructions of the United States Department of the Interior, Bureau of Land Management or by a decree of a court of law. Furthermore, that the corner points mentioned in lines 3, 4 and 5 above were, in a field survey on \_\_\_\_\_, 19\_\_\_\_, found, recovered, restored, established or re-established as expressed below and in conformance with the rules of the Michigan State Board of Registration for Land Surveyors or, by a Decree of a Court of law:

A. -Description of original monument and accessories and/or subsequent restoration:  
 C. (continued)

I-12  
 Found 1 1/4" pipe and added cedar post w/loc. tag  
 11" Maple S15°E 11.89  
 14" Maple N20°E 28.54

- B. Description of corner evidence found and/or method applied in restoring or re-establishing corner:
- H-11 Recovered 1" pipe as established by Salisbury and Sanders in 1969.
  - H-12 Recovered 3/4" pipe as established by Salisbury and Sanders in 1969.
  - I-11 Recovered sleigh shoe as recovered by Salisbury and Sanders in 1969.
  - I-12 Recovered 1 1/4" pipe as established by Salisbury and Sanders in 1969.

C. Description of monument for corner and accessories established to perpetuate locating the position of the corner:

H-11	H-12	I-11
Found & accepted 1" pipe, added cedar post w/loc. tag	Fd. & accepted 3/4" pipe, added cedar post w/loc. tag	Found sleigh shoe
14" Twin W. Oak S80°W 41.56	24" Basswood N55°E 90.60	Twin 12" Beech N45°E 3.74
7" W. Oak N45°W 52.18	14" Maple S88°E 99.35	43: Oak S40°E 65.28
Power Pole S60°E 18.40	NW leg steel S12°E 237.6	NE corner shed foundation S05°W 20.2
	Tower #991	


SIGNED BY Carl F. Roser 4-28-77 DATE \_\_\_\_\_

SURVEYOR'S MICHIGAN REGISTRATION NO. 12028

FOR STATE AND UNITED STATES AGENCIES:

SIGNED BY \_\_\_\_\_ DATE \_\_\_\_\_

APPROVED AND SIGNED BY \_\_\_\_\_ DATE \_\_\_\_\_

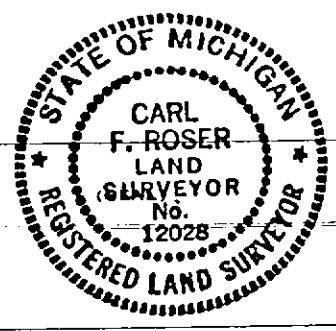

GARFIELD TOWNSHIP  
NEWAYGO COUNTY

SURVEYOR'S MICHIGAN REGISTRATION NO. \_\_\_\_\_