

LAND CORNER RECORDATION CERTIFICATE

FILING REQUIREMENT OF ACT 74, MICH. P.A.1970

FOR CORNERS OF--:	LOCATED IN--:	CORNER CODE NUMBER
1. PUBLIC LAND SURVEY _____	T. 12 ^{N.} R. 13 ^{W.}	H-13; I-13
2. PROPERTY CONTROLLING IN SECTION 34 _____	T. 12 ^{N.} R. 13 ^{W.}	1; 5
3. MISCELLANEOUS PROPERTY IN SECTION _____	T. _____ ^{N.} _{S.} R. _____ ^{E.} _{W.}	_____
4. LOT NO. _____, RECORDED PLAT _____		
5. PRIVATE CLAIMS _____		

REGISTER OF DEEDS STAMP AND FILING NUMBER

I, Carl F. Roser, do hereby certify that under requirements of P.A. 74, Michigan P.A. of 1970, the corner points mentioned in lines 1 and 2 above were, in a field survey on June 26, 1975, established, re-established, monumented, re-monumented, recovered or restored as expressed below and in conformance with regulations and rules therefore as required in the current manual of survey instructions of the United States Department of the Interior, Bureau of Land Management or by a decree of a court of law. Furthermore, that the corner points mentioned in lines 3, 4 and 5 above were, in a field survey on _____, 19____, found, recovered, restored, established or re-established as expressed below and in conformance with the rules of the Michigan State Board of Registration for Land Surveyors or, by a Decree of a Court of law:

~~A. Description of original monument and accessories and/or subsequent restorations~~

C. (continued)

5

Set 1½"x36" pipe and cedar post w/loc. tag

8" Basswood	N35°W	27.25
6" Maple	N25°E	14.03
5" Beech	S55°E	8.48
W'ly edge Muskegon River		
Due E		74'


- ~~H-13~~ B. Description of corner evidence found and/or method applied in restoring or re-establishing corner:
 Recovered 3/4" pipe as established by Salisbury and Sanders in 1969.
- ~~I-13~~ Recovered ½" pipe as recovered by Salisbury and Sanders in 1969.
- 1 Recovered 1½" pipe as recovered by Salisbury and Sanders in 1969.
- 5 Established corner equidistant and on line between found center of section to south and found ¼ corner to north.

C. Description of monument for corner and accessories established to perpetuate locating the position of the corner:

H-13	I-13	1
Fd. & accepted 3/4" pipe, add cedar post w/loc. tag	Fd. ½" pipe & Salisbury BT's	Fd. & accepted 1½" pipe
14" W. Oak N65°W 32.72	14" W. Oak S80°W 40.76	13" Cherry in clump of 5 N30°E 47.00
3-8" Maple S50°W 23.36	Power Pole N55°E 55.17	15" W. Oak N65°E 49.80
11" Twin Birch S80°E 13.18	NE cor. Sec. 3 (11-13) E 16.5	16" W. Oak Due W 34.78
	Set cedar post w/loc. tag	
	Due W 16.5	

SIGNED BY Carl F. Roser 4-28-77 DATE

SURVEYOR'S MICHIGAN REGISTRATION NO. 12028

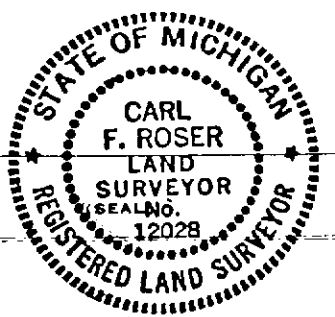

FOR STATE AND UNITED STATES AGENCIES:

SIGNED BY _____ DATE _____
CHIEF OF SURVEY PARTY

APPROVED AND SIGNED BY _____ DATE _____
MICHIGAN REGISTERED LAND SURVEYOR (SEAL)

SURVEYOR'S MICHIGAN REGISTRATION NO. _____ GARFIELD TOWNSHIP
 NEWAYGO COUNTY

MAY PLACE SKETCH ON BACK OR ATTACHED SHEET