

MAR 02 1999

1998 Newaygo County Remonumentation Project

'99 FEB 17 PM 3 37

**LAND CORNER RECORDATION CERTIFICATE
FILING REQUIREMENT of Act 74, Mich. P.A. 1970**

Linda M. Brown

SECTION

For corners in <u>Newaygo</u> (County)	Located in:	Corner Code #
1. Public Land Survey	T <u>12N</u> R <u>13W</u>	<u>B-7</u>
	T _____ R _____	_____
	T _____ R _____	_____
	T _____ R _____	_____
2. Property Controlling in Section	S _____ T _____ R _____	_____
	S _____ T _____ R _____	_____
3. Miscellaneous Property in Sec.	S _____ T _____ R _____	_____
	S _____ T _____ R _____	_____
4. Lot No. _____, Recorded Plat _____		
5. Private Claims _____		

VOL. 2

191

Register of Deeds Stamp & File Number

	A	B	C	D	E	F	G	H	I	J	K	L	M
1													
2	6	5	4	3	2	1							
3													
4	7	8	9	10	11	12							
5													
6	18	17	16	15	14	13							
7													
8	19	20	21	22	23	24							
9													
10	30	29	28	27	26	25							
11													
12	31	32	33	34	35	36							
13													

I, Norman L. Ochs, in a field survey on June 16, 1998, do hereby certify that under requirements of P. A. 74, Michigan P.A. of 1970, the corner points mentioned in lines 1 and 2 above were in conformance with regulations and rules therefore as required in the current manual of survey instructions of the United States Department of the Interior, Bureau of Land Management or by a decree of a Court of Law and/or that the corner points mentioned in lines 3, 4 and 5 above were in conformance with the rules of the Michigan Board of Land Surveyors or by a Decree of a Court of Law, established, re-established, monumented, re-monumented, recovered, found as expressed below:

Note: Not more than 4 corners, all in the same town and range, may be recorded on this certificate.

South One Quarter Corner, Section 18, Garfield Township, Newaygo County, Michigan.

A. DESCRIPTION OF ORIGINAL MONUMENT AND ACCESSORIES AND/OR SUBSEQUENT RESTORATION:

G.L.O. J.H. Mullett 1837
8" Beech N31°W 19 Links (12.54') #1
12" White Ash S81°E 14 Links (9.24') #2

Delos G. Anderson (County Surveyor)
Book A Pages 151 & 152 February 27, 1895
Book A Page 158 April 5, 1895
Established at proportional distance between the Northwest Corner and the Northeast Corner, Section 19
14" Rock Elm S14°E 50 Links (33') #3

Newaygo County Road Commission Sheet
Monument Box

Ralph A. Smith R.L.S. #3421
Book 84 Page 27 Undated
14" Rock Elm S14°E 33.00' #3
Gas Pipe North 25.00' #4
Gas Pipe South 25.00' #5

Patrick A. Salisbury R.L.S. #13594
September 1, 1971 LCRC #27
Used the center of iron

OVER ↵

B. DESCRIPTION OF CORNER EVIDENCE FOUND AND/OR METHOD APPLIED IN RESTORING OR REESTABLISHING CORNER:

Did not find any irons in monument box. Found broken glass and crockery 36"± below monument box on line ± with centerline of North and South over head electric lines and on line ± West fence going South. The centerline of the East and West bituminous road is 2"± South. The condition of the recorded witnesses are: #1 thru #5 gone, #6 thru #9 good condition.

C. DESCRIPTION OF MONUMENT FOR CORNER AND ACCESSORIES ESTABLISHED TO PERPETUATE LOCATING THE POSITION OF THE CORNER:

Removed broken glass, crockery and monument box and set a 2 3/4" X 20" Harrison cast iron monument marked "County Surveyor" in new 8" diameter monument box as a substantial marker for the section corner and is accepted as a careful and faithful reestablishment of the original corner.


Power Pole North 68.12' Found P.K. with tag "Advanced Survey and Map" in East side of pole. #6
12" Elm (blazed) S32°E 52.24' Set spike with tag #22439 in Easterly side of tree. #7
Power Pole S05°W 54.85' Set spike with tag #22439 in West side of tree. #8
18" Hickory (blazed) N33°W 54.38' Found spike with tag "Advanced Survey and Map" in West side of tree. #9

Signed by *Norman L. Ochs* Date October 15, 1998
Norman L. Ochs

Surveyor's Michigan License No. 22439 Form approved by Michigan State Board of Land Surveyors, Jan 28, 1971

Approved by Peer Review Group on October 22, 1998
Norman L. Ochs, County Representative.

N.L.O.

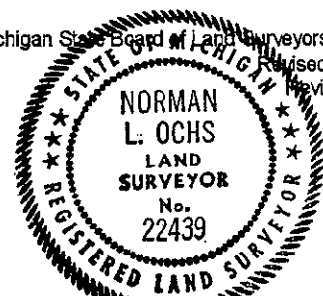

A. Description (cont.)

Donald G. Sandel R.L.S. #25870
December 19, 1979 No iron used centerline monument box.

William Fries, Jr. R.L.S. #30389
LCRC #984 April 20, 1990
Found empty Monument Box
Power Pole S79°E 67.98' #6
6" Elm S34°E 51.81' #7
Power Pole S04°W 54.74' #8
15" Elm N33°W 54.46' #9

SURVEY &
REMONUMENTATION

MAR 02 1999

SECTION