

MAR 02 1999

1998 Newaygo County Remonumentation Project

NEWAYGO COUNTY
REGISTER OF DEEDS
LINDA M. BROWN
FEB 17 PM 3 37

SECTION

**LAND CORNER RECORDATION CERTIFICATE
FILING REQUIREMENT of Act 74, Mich. P.A. 1970**

For corners in <u>Newaygo</u> (County)	Located in:	Corner Code #
1. Public Land Survey	T <u>12N</u> R <u>13W</u>	<u>F-7</u>
	T ___ R ___	_____
	T ___ R ___	_____
	T ___ R ___	_____
2. Property Controlling in Section	S ___ T ___ R ___	_____
	S ___ T ___ R ___	_____
3. Miscellaneous Property in Sec.	S ___ T ___ R ___	_____
	S ___ T ___ R ___	_____
4. Lot No. _____, Recorded Plat _____		
5. Private Claims _____		

Linda M. Brown
VOL. 2 195

Register of Deeds Stamp & File Number

	A	B	C	D	E	F	G	H	I	J	K	L	M
1													
2	6		5		4		3		2		1		
3													
4	7		8		9		10		11		12		
5													
6	18		17		16		15		14		13		
7													
8	19		20		21		22		23		24		
9													
10	30		29		28		27		26		25		
11													
12	31		32		33		34		35		36		
13													

I, Norman L. Ochs, in a field survey on June 15, 1998, do hereby certify that under requirements of P. A. 74, Michigan P.A. of 1970, the corner points mentioned in lines 1 and 2 above were in conformance with regulations and rules therefore as required in the current manual of survey instructions of the United States Department of the Interior, Bureau of Land Management or by a decree of a Court of Law and/or that the corner points mentioned in lines 3, 4 and 5 above were in conformance with the rules of the Michigan Board of Land Surveyors or by a Decree of a Court of Law; established, re-established, monumented, re-monumented, recovered, found as expressed below:

Note: Not more than 4 corners, all in the same town and range, may be recorded on this certificate.

South One Quarter Corner, Section 16, Garfield Township, Newaygo County, Michigan.

A. DESCRIPTION OF ORIGINAL MONUMENT AND ACCESSORIES AND/OR SUBSEQUENT RESTORATION:

G.L.O. J.H. Mullett 1837
12" Beech N62°E 25 Links (16.5')#1
12" Beech N40°W 26 Links (17.16')#2

Winfield S. Merrill (County Surveyor)
Book A Pages 87 and 88 April 13, 1887
36" Pine Stump N07°W 69 Links (45.54')#3
36" Pine Stump N71°E 34 Links (22.44')#4

Newaygo County Road Commission Sheet
Monument Box

Winfield S. Merrill (County Surveyor)
Book A Pages 115 and 116 April 5, 1889
Stone Corner

Lyle S. Shepherd R.L.S. #503
Witness Book Number 2, Page 84 Gas Pipe
Northwest Corner Church Foundation 78.5' #5
Gas Pipe South 25' #6

OVER ↘

B. DESCRIPTION OF CORNER EVIDENCE FOUND AND/OR METHOD APPLIED IN RESTORING OR REESTABLISHING CORNER:

Found 1/2" X 48" Rerod in monument box on line ± with centerline of the East and West bituminous road and on line ± with centerline of gravel road going South and there is no apparent occupation going North. The condition of the recorded witnesses are: #1 thru #8 gone, #9 thru #12 good condition.

C. DESCRIPTION OF MONUMENT FOR CORNER AND ACCESSORIES ESTABLISHED TO PERPETUATE LOCATING THE POSITION OF THE CORNER:

Removed Rerod and monument box and set a 2 3/4" X 20" Harrison cast iron monument marked "County Survey" in new 8" diameter monument box as a substantial marker for the section corner and is accepted as a careful and faithful reestablishment of the original corner.

32" Maple (blazed) N03°W 48.34' Found spike with tag in East side of tree. #9
24" White Pine (blazed) N27°E 51.68' Found spike with tag in Easterly side of tree. #10
Power Pole S27°E 58.17' Found P.K. nail with tag (illegible) in West side of pole. #11
Power Pole S55°W 83.03' Found P.K. nail with tag (illegible) in Southeasterly side of pole. #12

Signed by Norman L. Ochs


Date October 20, 1998

Surveyor's Michigan License No. 22439

Form approved by Michigan State Board of Land Surveyors, Jan 28, 1971
Revised May 14, 1975
Revised Jan., 1983

Approved by Peer Review Group on October 22, 1998
Norman L. Ochs, County Representative.

M.L.O.

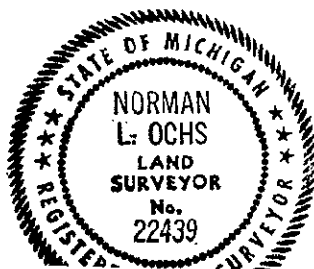

A. Description (cont.)

Michigan State Highway Department
State Project 062-23 Route M-82
December 12, 1928 3" Pipe
Twin Ash S23°E 66.0' #7
10" Maple S27°W 48.8' #8
10" Maple N03°W 48.1' #9

Maurice J. Rosema R.L.S. #27459
1987 Found 1/2" Rod in monument box
30" Maple North 48.88' #9
13" Pine North - Northeast 51.77' #10
Power Pole Southeast 58.19' #11
Power Pole Southwest 83.09' #12

SURVEY &
REMONUMENTATION

MAR 02 1999

SECTION