

SURVEY & REMONUMENTATION

MAR 02 1999

SECTION

1998 Newaygo County Remonumentation Project

NEWAYGO COUNTY
REGISTER OF DEEDS
LINDA M. BROWN

**LAND CORNER RECORDATION CERTIFICATE
FILING REQUIREMENT of Act 74, Mich. P.A. 1989**

FEB 17 PM 3 37

Linda M. Brown

VOL. 2

196

For corners in <u>Newaygo</u> (County)	Located in:	Corner Code #
1. Public Land Survey	T <u>12N</u> R <u>13W</u>	<u>G-7</u>
	T ___ R ___	_____
	T ___ R ___	_____
	T ___ R ___	_____
2. Property Controlling in Section	S ___ T ___ R ___	_____
	S ___ T ___ R ___	_____
3. Miscellaneous Property in Sec.	S ___ T ___ R ___	_____
	S ___ T ___ R ___	_____
4. Lot No. _____, Recorded Plat _____		
5. Private Claims _____		

Register of Deeds Stamp & File Number

	A	B	C	D	E	F	G	H	I	J	K	L	M
1													
2	6	5	4	3	2	1							
3													
4	7	8	9	10	11	12							
5													
6	18	17	16	15	14	13							
7													
8	19	20	21	22	23	24							
9													
10	30	29	28	27	26	25							
11													
12	31	32	33	34	35	36							
13													

I, Norman L. Ochs, in a field survey on June 15, 1998, do hereby certify that under requirements of P. A. 74, Michigan P.A. of 1970, the corner points mentioned in lines 1 and 2 above were in conformance with regulations and rules therefore as required in the current manual of survey instructions of the United States Department of the Interior, Bureau of Land Management or by a decree of a Court of Law and/or that the corner points mentioned in lines 3, 4 and 5 above were in conformance with the rules of the Michigan Board of Land Surveyors or by a Decree of a Court of Law, established, re-established, monumented, re-monumented, recovered, found as expressed below.

Note: Not more than 4 corners, all in the same town and range, may be recorded on this certificate.

Southwest Corner, Section 15, Garfield Township, Newaygo County, Michigan.

A. DESCRIPTION OF ORIGINAL MONUMENT AND ACCESSORIES AND/OR SUBSEQUENT RESTORATION:

G.L.O. J.H. Mullett 1837
12" Beech N30°E 50 Links (33.00') #1
19" Beech N65°W 21 Links (13.86') #2

Winfield S. Merrill (County Surveyor)
Book A Pages 115 and 116 April 5, 1889
Stakes two rods North and two rods West #3
Stakes two rods South and two rods West #4

Newaygo County Road Commission Sheet
Monument Box

Lyle S. Shepherd R.L.S. #503
Witness Book Number 2 Page 81
Monument Box
Corner School N40°E 193 Links (127.38') #5
Red Oak Southwest 116.00' #6

Michigan State Highway Department
Project 062-23 Route M-82 3" Pipe
Iron Pipe S43°E 35.8' #7
Telephone Pole S29°W 42.1' #8
10" Maple N35°E 61.3' #9

OVER ↙

B. DESCRIPTION OF CORNER EVIDENCE FOUND AND/OR METHOD APPLIED IN RESTORING OR REESTABLISHING CORNER:

Found 1/2" Rerod driven into a 1 1/4" X 44" Iron Pipe with broken glass in monument box on line ± with centerline of bituminous road going South. The centerline of the East and West bituminous road is 1 foot South and the centerline of bituminous road going North is 2' West. The condition of the recorded witnesses are: #1 thru #4 gone, #5 and #6 good condition, #7 thru #8 gone, #9 good condition.

C. DESCRIPTION OF MONUMENT FOR CORNER AND ACCESSORIES ESTABLISHED TO PERPETUATE LOCATING THE POSITION OF THE CORNER:

Removed Rerod, Iron Pipe and monument box and set a 2 3/4" X 20" Harrison cast iron monument marked "County Surveyor" in new 8" diameter monument box as a substantial marker for the section corner and is accepted as a careful and faithful reestablishment of the original corner.


Southwest Corner "Standard School" (Garfield Township) N40°E 127.28' #5
60" Red Oak S19°W 116.32' Found spike in East side of tree. #6
36" Maple N35°E 61.30' Set spike with tag #22439 in West side of tree. #9
Power Pole S60°E 107.38' Found spike in North side of pole.
Northeast Corner East sign post to "Stop" sign N16°W 66.73'

Signed by Norman L. Ochs Date October 15, 1998
Norman L. Ochs
Surveyor's Michigan License No. 22439

Form approved by Michigan State Board of Land Surveyors, Lansing, Michigan, 1975
Revised Jan., 1983

Approved by Peer Review Group on October 22, 1998
Norman L. Ochs, County Representative.

N.L.O.

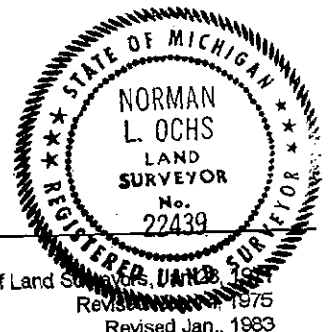

A. Description (cont.)

C.F. Zimmerman C.E. #7301
December 23, 1961 Monument Box

Patrick A. Salisbury R.L.S. #13594
LCRC #34 August 19, 1971
Monument Box used the center of iron.

SURVEY &
REMONUMENTATION

MAR 02 1999

SECTION