

**SURVEY &
REMONUMENTATION**

APR 24 1995

COMMISSION

1994 NEWAYGO COUNTY REMONUMENTATION PROJECT
LAND CORNER RECORDATION CERTIFICATE
Filing Requirement of Act 74, Mich. P.A. 1970

VOL: **001** PAGE **97**

For corners in
Newaygo (County) Located In: Corner Code #


1. Public Land Survey	T <u>12N</u> R <u>14W</u>	<u>G-11</u>
	T _____ R _____	_____
	T _____ R _____	_____
	T _____ R _____	_____
2. Property Controlling in Section	S _____ T _____ R _____	_____
	S _____ T _____ R _____	_____
3. Miscellaneous Property in Sec.	S _____ T _____ R _____	_____
	S _____ T _____ R _____	_____
4. Lot No. _____, Recorded Plat _____		
5. Private Claims _____		

NEWAYGO COUNTY
REGISTER OF DEEDS
MARLENE TOOGOOD

'95 MAR 14 PM 3 5

Marlene Toogood
Register of Deeds Stamp & File Number

I, Norman L. Ochs, in a field survey on November 12, 19 94, do hereby certify that under requirements of P.A. 74, Michigan P.A. of 1970, the corner points mentioned in lines 1 and 2 above were in conformance with regulations and rules therefore as required in the current manual of survey instructions of the United States Department of the Interior, Bureau of Land Management or by a decree of a Court of Law and/or that the corner points mentioned in lines 3, 4 and 5 above were in conformance with the rules of the Michigan Board of Land Surveyors or by a Decree of a Court of Law; established, re-established, monumented, re-monumented, recovered, found as expressed below:

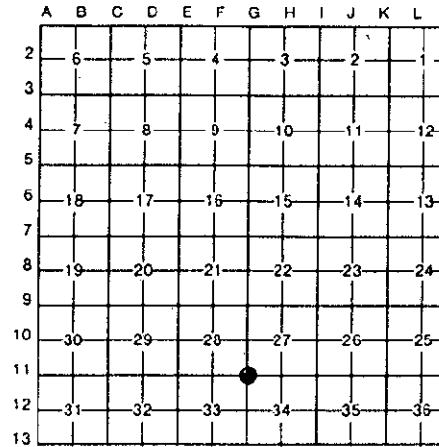

NOTE: Not more than 4 corners, all in the same town and range, may be recorded on this certificate.
S.W. Corner, Section 27, Sheridan Twp., Newaygo Co., MI

A. Description of original monument and accessories and/or subsequent restoration:

G.L.O. John Mullett 1837
10" Hemlock S20°E 22 lks. (14.52') #1
6" Hemlock N36°W 32 lks. (21.12') #2

Norman L. Ochs R.L.S. #22439 L.C.R.C. #602
April 19, 1978 Found 1" Iron
3"-6" Tw. Maple S87°W 38.5' #3 4" & 5" Basswood
10" Hemlock N26°W 57.88' #5 N57°W 28.85' #4
Measured 2649.90 feet from the W. 1/4 Cor. to the S.W. Cor. of Sec. 27. Measured 2644.61 feet from the S.W. Cor. to the S. 1/4 Cor. of Sec. 27.


N.C.R.C. Sheet Measured 2649.90 feet from
1" Iron E. 1/4 Cor. to the S.E. Cor. of Sec. 28. Measured 2610.75
(3) 6" Maples S87°W 38.5' #3 feet from the S.E. Cor. to
4" Basswood N57°W 28.85' #4 the S. 1/4 Cor. of Sec. 28.
10" Hemlock N26°W 57.88' #5

B. Description of corner evidence found and/or method applied in restoring or reestablishing corner: OVER----->

On November 12, 1994, I, Norman L. Ochs, found 1" Iron on top of another 1" Iron. The centerline of North and South road in 4 feet East of corner and is on woods line going East. The condition of recorded witnesses are: #1 and #2 Gone, #3 Good Condition, #4 Stump, #5 Good Condition.

C. Description of monument for corner and accessories established to perpetuate locating the position of the corner:

Removed 1" Irons and set a 4" dia. Harrison Cast Iron Monument 20" long stamped County Surveyor as a substantial marker for the section corner and is accepted as a careful and faithful reestablishment of the original corner.
6" & 3" Tw. Maples S40°E 49.97' Spike on East side of tree
10" Maple East 88.42' Spike on South side of tree
(3) 10" Maples S87°W 38.56' Spike on North side of trees #3
10" Hemlock N26°W 58.29' Spike on East side of tree #5
Basswood Stump N57°W 28.96' Found spike in stump #4

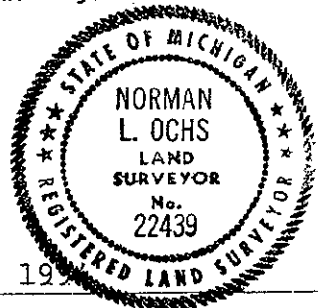

Signed by Norman L. Ochs Date November 14, 1994
Surveyor's Michigan License No. #22439

Approved by Peer Review Group on December 1, 1994
Norman L. Ochs, County Representative.

A. Description.....(Continued)

Robert J. Jonker R.L.S.

January 24, 1986 File No. 86028

Measured 2608.14 feet from the N.E. Cor. to the N. 1/4 Cor. of Sec. 33. Measured 2659.83 feet from the N.E. Cor. to the E. 1/4 Cor. of Sec. 33.