

MAR 02 1999

1998 Newaygo County Remonumentation Project

NEWAYGO COUNTY REGISTER OF DEEDS LINDA M. BROWN

SECTION

LAND CORNER RECORDATION CERTIFICATE FILING REQUIREMENT of Act 74, Mich. P.A. 1970

'99 FEB 17 PM 3 36

Linda M. Brown

VOL. 2

182

For corners in Newaygo (County) Located in: _____ Corner Code # _____

1. Public Land Survey T 12N R 14W _____ K-5 _____
 T _____ R _____
 T _____ R _____
 T _____ R _____

2. Property Controlling in Section S _____ T _____ R _____
 S _____ T _____ R _____

3. Miscellaneous Property in Sec. S _____ T _____ R _____
 S _____ T _____ R _____

4. Lot No. _____, Recorded Plat _____

5. Private Claims _____

Register of Deeds Stamp & File Number

| | A | B | C | D | E | F | G | H | I | J | K | L | M |
|----|----|---|----|---|----|---|----|---|----|---|----|---|---|
| 1 | | | | | | | | | | | | | |
| 2 | 6 | | 5 | | 4 | | 3 | | 2 | | 1 | | |
| 3 | | | | | | | | | | | | | |
| 4 | 7 | | 8 | | 9 | | 10 | | 11 | | 12 | | |
| 5 | | | | | | | | | | | | | |
| 6 | 18 | | 17 | | 16 | | 15 | | 14 | | 13 | | |
| 7 | | | | | | | | | | | | | |
| 8 | 19 | | 20 | | 21 | | 22 | | 23 | | 24 | | |
| 9 | | | | | | | | | | | | | |
| 10 | 30 | | 29 | | 28 | | 27 | | 26 | | 25 | | |
| 11 | | | | | | | | | | | | | |
| 12 | 31 | | 32 | | 33 | | 34 | | 35 | | 36 | | |
| 13 | | | | | | | | | | | | | |

I, Norman L. Ochs, in a field survey on June 23, 1998, do hereby certify that under requirements of P. A. 74, Michigan P.A. of 1970, the corner points mentioned in lines 1 and 2 above were in conformance with regulations and rules therefore as required in the current manual of survey instructions of the United States Department of the Interior, Bureau of Land Management or by a decree of a Court of Law and/or that the corner points mentioned in lines 3, 4 and 5 above were in conformance with the rules of the Michigan Board of Land Surveyors or by a Decree of a Court of Law, established, re-established, monumented, re-monumented, recovered, found as expressed below:

Note: Not more than 4 corners, all in the same town and range, may be recorded on this certificate.

Northeast Corner, Section 14, Sheridan Township, Newaygo County, Michigan.

A. DESCRIPTION OF ORIGINAL MONUMENT AND ACCESSORIES AND/OR SUBSEQUENT RESTORATION:

G.L.O. John Mullett 1838
 18" Hemlock N81°E 14 Links (9.24')#1
 10" Hemlock S70°W 20 Links (13.2')#2

Delos G. Anderson (County Surveyor)
 Book A Pages 161 and 162 March 30, 1895
 Stone Corner Old Government Corner

Newaygo County Road Commission Sheet
 Monument Box in pavement

Delos G. Anderson (County Surveyor)
 August 27, 1903 Book A Page 385
 Large Stone for Corner

William M. Jacques (County Surveyor)
 August 27, 1904 Book B Pages 6 and 7
 Large Stone for corner

OVER ↙

B. DESCRIPTION OF CORNER EVIDENCE FOUND AND/OR METHOD APPLIED IN RESTORING OR REESTABLISHING CORNER:

Found 1" X 20" Iron Pipe in monument box and large stone (at least 12" in diameter) on line ± with the centerline of the East and West bituminous road and the centerline of the North and South bituminous road is 3 feet ± East. The condition of the recorded witnesses are: #1 thru #4 gone, #5 thru #8 good condition.

C. DESCRIPTION OF MONUMENT FOR CORNER AND ACCESSORIES ESTABLISHED TO PERPETUATE LOCATING THE POSITION OF THE CORNER:

Removed Iron Pipe and a set 2 3/4" X 20" Harrison cast iron monument marked "County Survey" in new 8" diameter monument box as a substantial marker for the section corner and is accepted as a careful and faithful reestablishment of the original corner.

- 18" Elm N37°E 106.37' Set new spike with tag #22439 in Southeast side of tree. #5
- Westerly 10" Sign Post S38°E 92.42' to centerline. #6
- Power Pole S51°W 69.57' Found P.K. nail with tag "Advanced Survey & Map" in Southeasterly side of pole. #7
- 6" X 6" Sign Post (Hidden Acres Cottages 1.5 miles) N44°W 66.85' Found P.K. nail with tag "Advanced Survey & Map" in Northeast corner of post. #8
- Power Pole S48°E 67.30' Set spike with tag #22439 in Northeasterly side of pole.


Signed by Norman L. Ochs Date October 15, 1998
 Norman L. Ochs

Surveyor's Michigan License No. 22439

Form approved by Michigan State Board of Land Surveyors, Jan 28, 1971
 Revised May 14, 1975
 Revised Jan., 1993

Approved by Peer Review Group on October 22, 1998
 Norman L. Ochs, County Representative.

N.L.O.

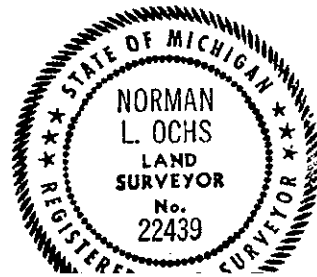

A. Description (cont.)

William M. Jacques (County Surveyor)
April 22, 1910 Book B Pages 42 and 43
Stone Corner with broken glass around

Lyle S. Shepherd R.L.S. #503
Witness Book Number 2 Page 64
Monument Box
Southeast Corner Wall S26 $\frac{3}{4}$ °W 25' #3
"X" on East Abutment S54 $\frac{1}{4}$ °E 18.7' #4

Michigan State Highway Department
Project 062-23 Route M-82
December 12, 1928 2" Pipe
Center of East Abutment S54°15'E 18.75' #4
East Corner of Wing Wall S26°45'W 25' #3

William Fries, Jr. R.L.S. #30389
LCRC #1138 March 22, 1992
Found 1 3/8" outside diameter Pipe in Monument Box 2.3 feet West of occupied centerline of North and South roadway.
8" Elm N37°E 106.58' #5
Westerly 6" outside diameter Sign Support S39°E 92.42' #6
Power Pole S51°W 69.63' #7
6" X 6" Sign Post N46°W 66.95' #8

SURVEY &
REINFORCEMENT

MAR 02 1999

SECTION