

**SURVEY & REMONUMENTATION**

MAR 02 1999

1998 Newaygo County Remonumentation Project

NEWAYGO COUNTY REGISTER OF DEEDS  
LINDA M. BROWN

**LAND CORNER RECORDATION CERTIFICATE**  
FILING REQUIREMENT of Act 74, Mich. P.A. 1970

FEB 17 PM 3 36

**SECTION**

For corners in <u>Newaygo</u> (County)	Located in:	Corner Code #
1. Public Land Survey	T <u>12N</u> R <u>14W</u>	<u>K-6</u>
	T ___ R ___	_____
	T ___ R ___	_____
	T ___ R ___	_____
2. Property Controlling in Section	S ___ T ___ R ___	_____
	S ___ T ___ R ___	_____
3. Miscellaneous Property in Sec.	S ___ T ___ R ___	_____
	S ___ T ___ R ___	_____
4. Lot No. _____, Recorded Plat _____		
5. Private Claims _____		

*Linda M. Brown*

VOL. 2

183

**Register of Deeds Stamp & File Number**

	A	B	C	D	E	F	G	H	I	J	K	L	M
1													
2	6	5	4	3	2	1							
3													
4	7	8	9	10	11	12							
5													
6	18	17	16	15	14	13							
7													
8	19	20	21	22	23	24							
9													
10	30	29	28	27	26	25							
11													
12	31	32	33	34	35	36							
13													

I, Norman L. Ochs, in a field survey on June 23, 1998, do hereby certify that under requirements of P. A. 74, Michigan P.A. of 1970, the corner points mentioned in lines 1 and 2 above were in conformance with regulations and rules therefore as required in the current manual of survey instructions of the United States Department of the Interior, Bureau of Land Management or by a decree of a Court of Law and/or that the corner points mentioned in lines 3, 4 and 5 above were in conformance with the rules of the Michigan Board of Land Surveyors or by a Decree of a Court of Law; established, re-established, monumented, re-monumented, recovered, found as expressed below:

**Note: Not more than 4 corners, all in the same town and range, may be recorded on this certificate.**

East One Quarter Corner, Section 14, Sheridan Township, Newaygo County, Michigan.

**A. DESCRIPTION OF ORIGINAL MONUMENT AND ACCESSORIES AND/OR SUBSEQUENT RESTORATION:**

G.L.O. John Mullett 1838  
8" Beech S21°E 14 Links (9.24') #1  
6" Black Ash N46°W 24 Links (15.84') #2

William M. Jacques (County Surveyor)  
August 27, 1903 Book A Page 385  
Stake with broken glass

Newaygo County Road Commission Sheet  
Monument Box in pavement

William M. Jacques (County Surveyor)  
August 27, 1904 Book Pages 6 and 7  
Iron Stake

William Fries, Jr. R.L.S. #30389  
October 10, 1988 LCRC #847  
Found Monument Box but could not open.  
Sign Post N85°E 55.07' #3  
1/2" Rod and cap S87°E 50.02' #4  
28" Maple S52°W 39.69' #5  
Power Pole N87°W 52.61' #6

Carl Englert, Jr. R.L.S. #18987  
March 10, 1990 LCRC #1102  
2" X 2" Iron in Monument Box  
8" Elm Northeast 74.00' #7  
Sign Post East - Northeast 55.11' #3  
28" Maple Southwest 39.72' #5  
Power Pole West 52.88' #6

**B. DESCRIPTION OF CORNER EVIDENCE FOUND AND/OR METHOD APPLIED IN RESTORING OR REESTABLISHING CORNER:**

Found 2" X 2" X 28" Iron bar in monument box and the centerline of the North and South bituminous road is 2.5 feet ± East and the centerline of the East and West culvert is 4 feet ± South. There is no apparent East and West occupation. The condition of the recorded witnesses are: #1 thru #3 gone, #4 thru #6 good condition, #7 dead.

**C. DESCRIPTION OF MONUMENT FOR CORNER AND ACCESSORIES ESTABLISHED TO PERPETUATE LOCATING THE POSITION OF THE CORNER:**

Removed Iron bar and monument box and set a 2 3/4" X 20" Harrison cast iron monument marked "County Survey" in a new 8" diameter monument box as a substantial marker for the section corner and is accepted as a careful and faithful reestablishment of the original corner.


1/2" Rerod with cap #30389 S87°E 50.23' #4  
32" Maple S49°W 40.5' Set spike with tag #22439 in North side of tree. #5  
Power Pole N87°W 52.73' Found P.K. nail with tag #30389 in South side of pole. #6  
10" Elm (dead) N45°E 74.00' ± to center. #7  
8" - 10" Twin Elm (blazed) East 48.58' Set spike with tag #22439 in South side of tree.  
4" Elm S40°E 64.35' Set spike with tag #22439 in Northeast side of tree.

Signed by Norman L. Ochs Date October 15, 1998

Surveyor's Michigan License No. 22439

Form approved by Michigan State Board of Land Surveyors, Jan 28, 1971

Approved by Peer Review Group on October 22, 1998  
Norman L. Ochs, County Representative.

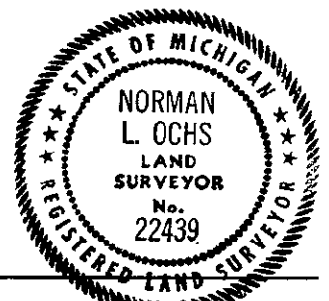

Revised May 14, 1975  
Revised Jan., 1983

*M.L.O.*