

SURVEY & RE-MONUMENTATION

APR 04 1996

1995 Newaygo County Remonumentation Project

COMMISSION

LAND CORNER RECORDATION CERTIFICATE
FILING REQUIREMENT of Act 74, Mich. P.A. 1970

NEWAYGO COUNTY
REGISTER OF DEEDS
MARLENE TOOGOOD

'88 FEB 21 AM 9 39

For corners in <u>Newaygo</u> (County)	Located in:	Corner Code #
1. Public Land Survey	T <u>12N</u> R <u>14W</u>	<u>L-11</u>
	T ___ R ___	_____
	T ___ R ___	_____
	T ___ R ___	_____
2. Property Controlling in Section	S ___ T ___ R ___	_____
	S ___ T ___ R ___	_____
3. Miscellaneous Property in Sec.	S ___ T ___ R ___	_____
	S ___ T ___ R ___	_____
4. Lot No. _____, Recorded Plat _____		
5. Private Claims _____		

Marlene Toogood
VOL. 1 PAGE 173

Register of Deeds Stamp & File Number

A	B	C	D	E	F	G	H	I	J	K	L	M
2	6	5	4	3	2							
3												
4	7	8	9	10	11	12						
5												
6	18	17	16	15	14	13						
7												
8	19	20	21	22	23	24						
9												
10	30	29	28	27	26	25						
11												
12	31	32	33	34	35	36						
13												

I, Norman L. Ochs, in a field survey on June 4, 1995, do hereby certify that under requirements of P. A. 74, Michigan P.A. of 1970, the corner points mentioned in lines 1 and 2 above were in conformance with regulations and rules therefore as required in the current manual of survey instructions of the United States Department of the Interior, Bureau of Land Management or by a decree of a Court of Law and/or that the corner points mentioned in lines 3, 4 and 5 above were in conformance with the rules of the Michigan Board of Land Surveyors or by a Decree of a Court of Law; established, re-established, monumented, re-monumented, recovered, found as expressed below:

Note: Not more than 4 corners, all in the same town and range, may be recorded on this certificate.

N. 1/4 Corner, Section 36, Sheridan Twp., Newaygo Co., MI

A. DESCRIPTION OF ORIGINAL MONUMENT AND ACCESSORIES AND/OR SUBSEQUENT RESTORATION:

G.L.O. John Mullett 1838 18" Hemlock S05°W 10Lks (6.60')#1 10" Hemlock N2°E 19Lks (12.54')#2	Delos G. Anderson (Co. Surveyor) Book A. Pg. 332 Jan. 7 & 8, 1902 Measured 40.80 ch (2692.80 ft) from the S.W. Cor. to the S. 1/4 Cor. of Sec. 25 and measured 40.80 ch (2692.80 ft) from the S. 1/4 Cor. to the S.E. Cor. of Sec. 25
Delos G. Anderson (Co. Surveyor) Book A Pg. 329 Dec. 6 & 7, 1901 and Book 14 Pg's 8 thru 10 Measured 40.40 ch (2666.40 ft) from the N.W. Cor. to the N. 1/4 cor of Sec. 36. Found original bearing stp. set a Pine root stake with broken crockery. Pine Stp. N32°W 25 ft #3	Ralph A. Smith RLS # 3421 Book 56 Pg. 44 Nov. 7, 1950 Measured 5332.80 ft from the N.W. Cor. to the N.E. Cor. of Sec. 36 Measured 2666.40 ft from the N.W. Cor. to the N. 1/4 Cor. of Sec. 36
Newaygo Engineering and Survey Co. See Drawing No. 78097M May 30, 1978 Found 1" pipe in centerline of E & W road Fence post North 32.52' #4 P. Pole N80°E 170.08' #5	NCRC Sheet Measured 5293.90 ft from the N.W. Cor. to the N.E. Cor. of Sec. 36

B. DESCRIPTION OF CORNER EVIDENCE FOUND AND/OR METHOD APPLIED IN RESTORING OR REESTABLISHING CORNER:


Found 1" pipe in centerline of E & W road. There is a fence going North and also down fence going South. I measured 2695.49 ft from the N.W. Cor. to the N. 1/4 Cor. and measured 2710.74 ft from the N. 1/4 Cor. to the N.E. Cor. of Sec. 36 and the condition of the recorded witnesses are: #1 thru #3 gone, #4 good condition, #5 gone

C. DESCRIPTION OF MONUMENT FOR CORNER AND ACCESSORIES ESTABLISHED TO PERPETUATE LOCATING THE POSITION OF THE CORNER:

Removed 1" pipe and set a 4" dia. Harrison cast iron monument 20" long marked "County Surveyor" as a substantial marker for the section corner and is accepted as a careful and faithful reestablishment of the original corner.

6" dia. fence post North 33.11' Found spike in West side of post. #4
Utility Pole N80°E 216.29' Spike in North side of pole.
30" Maple S79°E 181.62' Spike in South side of tree.
Utility Pole N80°W 170.10' Spike in South side of pole.

Signed by Norman L. Ochs Date September 11, 1995
Surveyor's Michigan License No. 22439

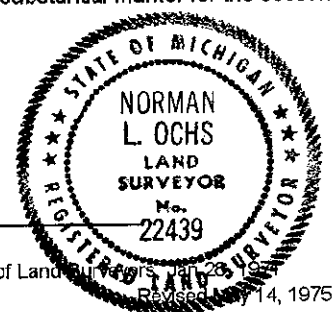

Approved by Peer Review Group On September 26, 1995
Norman L. Ochs, County Representative.

N. L. O.

Form approved by Michigan State Board of Land Surveyors, Revised Jan., 1983