

**SURVEY &
REMONUMENTATION**

APR 24 1995 1994 NEWAYGO COUNTY REMONUMENTATION PROJECT

VOL 001 PAGE 99

COMMISSION

LAND CORNER RECORDATION CERTIFICATE
Filing Requirement of Act 74, Mich. P.A. 1970

For corners in

Newaygo

(County)

Located In:

Corner Code #

1. Public Land Survey	T	<u>13N</u>	R	<u>11W</u>	C-9
	T	_____	R	_____	_____
	T	_____	R	_____	_____
	T	_____	R	_____	_____
2. Property Controlling in Section	S	_____	T	_____	_____
	S	_____	T	_____	_____
3. Miscellaneous Property in Sec.	S	_____	T	_____	_____
	S	_____	T	_____	_____

NEWAYGO COUNTY
REGISTER OF DEEDS
MARLENE TOOGOOD


'95 MAR 14 PM 3 55

Marlene Toogood

Register of Deeds Stamp & File Number

4. Lot No. _____, Recorded Plat _____
5. Private Claims _____

I, Norman L. Ochs, in a field survey on October 29, 1994, do hereby certify that under requirements of P.A. 74, Michigan P.A. of 1970, the corner points mentioned in lines 1 and 2 above were in conformance with regulations and rules therefore as required in the current manual of survey instructions of the United States Department of the Interior, Bureau of Land Management or by a decree of a Court of Law and/or that the corner points mentioned in lines 3, 4 and 5 above were in conformance with the rules of the Michigan Board of Land Surveyors or by a Decree of a Court of Law; established, re-established, monumented, re-monumented, recovered, found as expressed below:

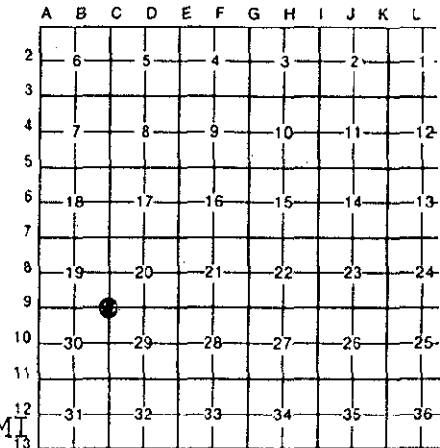

NOTE: Not more than 4 corners, all in the same town and range, may be recorded on this certificate.

N.E. Corner, Section 30, Big Prairie Twp., Newaygo Co., MI

A. Description of original monument and accessories and/or subsequent restoration:

- | | |
|--|---|
| G.L.O. John Hodgeson 1837 | Patrick A. Salisbury R.L.S. #13594 Sept. 22, 1975 |
| 12" B. Oak S69°E 40 lks. (26.40') #1 | Found Spike and old witness trees w/nails - Reset 3/4" Pipe |
| 10" B. Oak N41°E 96 lks. (63.36') #2 | 10" R. Oak N86°E 24.34' #6 |
| | 36" B. Oak N31°E 61.40' to the face, #7 |
| | 62.50' to the N.W. side of tree |
| Paul Paquette R.L.S.# | 12"-10"- Tw. R. Oak S70°W 32.67' #8 |
| 1971 Nail (Presumed to be set by Paul) | 14" R. Oak N60°W 80.63' #9 |
| 10" B. Oak S77°W 34.60' #3 | |
| 10" B. Oak N39°E 26.40' #4 | |
| 28" B. Oak N63°E 64.62' #5 | |

OVER----->


B. Description of corner evidence found and/or method applied in restoring or reestablishing corner:

Found a 3/4" Pipe with smashed cap and measured 2648.30 feet from the NE. Cor. to the E. 1/4 Cor. of Sec. 30 and condition of recorded witnesses are: #1 and #2 Gone, #3 decayed stump only, #4 and #5 Gone, #6 and #7 Good Condition, #8 Gone, #9 Good Condition. In centerline of gravel road. There is an old fence on ground East and West. Also dug at bearing and distance from bearing tree No. 7, to try and determine if it was a O.B.T., did not find any evidence. It fell +- 3 feet West of road. I do not feel it is an O.B.T.

C. Description of monument for corner and accessories established to perpetuate locating the position of the corner:

- Removed 3/4" Pipe and set a 4" dia. Harrison Cast Iron Monument 20" long marked "County Surveyor" as a substantial marker for the section corner and is accepted as a careful and faithful reestablishment of the original corner.
- 12" Oak N86°E 24.35' Found spike in South side of tree #6
 - 40" Oak N31°E 62.54' Found spike in NW. side of tree #7
 - 24" Oak N60°W 80.63' Found spike in North side of tree #9
 - 10" Oak S75°W 67.49' Set spike in North side of tree

Signed by *Norman L. Ochs* Date November 30, 1994
Surveyor's Michigan License No. #22439

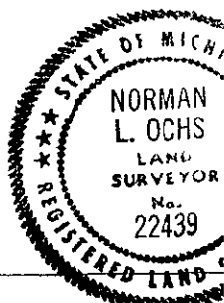

Approved by Peer Review Group on December 15, 1994
Norman L. Ochs, County Representative. *N.L.O.*

A. Description.....(Continued)

Patrick A. Salisbury R.L.S. #13594 Sept. 22, 1975

Measured 2663.61 feet from the SW. Cor. to the W. 1/4 Cor. of Sec. 20 and measured 2645.20 feet from the SW. Cor. to the S. 1/4 Cor. of Sec. 20.

Wayne R. Griffin R.L.S. #35993 January 29, 1993

Measured 5383.84 feet from the NE. Cor. to the NW. cor. of Sec. 30 and measured 2649.69 feet from the SE. Cor. to the S. 1/4 Cor. of Sec. 19 and measured 2663.86 feet from the SE. Cor. to the E. 1/4 Cor. of Sec. 19.

Newaygo Engineering and Survey Co. March 31, 1993

Measured 2648.07 feet from the NE. Cor. to the E. 1/4 Cor. of Sec. 30 and measured 5383.95 feet from the NE. Cor. to the NW. Cor. of Sec. 30 and measured 2647.30 feet from the NE. Cor. to the N. 1/4 Cor. of Sec. 30.

William Fries Jr. R.L.S. #30389 October 16, 1993

Measured 5383.86 feet from the NE. Cor. to the NW. Cor. of Sec. 30 and measured 2647.26 feet from the NE. Cor. to the N. 1/4 Cor. of Sec. 30.