

MAY 28 1987

COMMISSIONER

1996 Newaygo County Remonumentation Project

NEWAYGO COUNTY REGISTER OF DEEDS LINDA M. BROWN

'97 FEB 12 PM 4 45

LAND CORNER RECORDATION CERTIFICATE FILING REQUIREMENT of Act 74, Mich. P.A. 1970

Linda M. Brown

For corners in Newaygo (County) Located in: Corner Code # 1. Public Land Survey T 13N R 11W G-4 2. Property Controlling in Section S T R 3. Miscellaneous Property in Sec. S T R 4. Lot No. , Recorded Plat 5. Private Claims

VOL. 1 PAGE 235

Register of Deeds Stamp & File Number

Grid with columns A-M and rows 2-13. A dot is present in row 4, column G.

I, Norman L. Ochs, in a field survey on October 1, 1996, do hereby certify that under requirements of P. A. 74, Michigan P.A. of 1970, the corner points mentioned in lines 1 and 2 above were in conformance with regulations and rules therefore as required in the current manual of survey instructions of the United States Department of the Interior, Bureau of Land Management or by a decree of a Court of Law and/or that the corner points mentioned in lines 3, 4 and 5 above were in conformance with the rules of the Michigan Board of Land Surveyors or by a Decree of a Court of Law; established, re-established, monumented, re-monumented, recovered, found as expressed below:

Note: Not more than 4 corners, all in the same town and range, may be recorded on this certificate.

West One Quarter Corner, Section 10, Big Prairie Township, Newaygo County, Michigan

A. DESCRIPTION OF ORIGINAL MONUMENT AND ACCESSORIES AND/OR SUBSEQUENT RESTORATION:

G.L.O. James H. Mullett 1839 36" Pine S51°E 9 Links (5.94')#1 10" White Oak S70°W 45 Links (29.7')#2

Ralph A. Smith R.L.S. #3421 December 5, 1961 Book 70 Page 142 10" Triple Elm N20°E 23.61' #5 12" Elm N35°W 63.9' #6

NCRC Sheet 1935 Sleigh Shoe 5" Apple S51°E 44.2' #3 15" Black Oak S71½°W 70.0' #4

Patrick A. Salisbury R.L.S. #13594 Found 2½" X ¾" Sleigh Shoe December 14, 1976 Recorded in Series J Number 6952 24" Black Oak S76°W 70.31' #4 5" White Pine N41°W 75.57' #7

William Fries Jr. R.L.S. #30389 LCRC # 1019 May 22, 1990 Found 3" X 1½" Sleigh Shoe in occupied centerline of road going East and West and 12' East of occupied centerline of road going North. Iron and cap #30389 East 147.24' #8 Fence Post with 9" cap S42°W 54.57' #9 24" Red Oak S71°W 70.37' #4 6"-15" Maple N68°W 100.98' #10

B. DESCRIPTION OF CORNER EVIDENCE FOUND AND/OR METHOD APPLIED IN RESTORING OR REESTABLISHING CORNER:

Found 2½" X ¾" Sleigh Shoe in the centerline of road going West and in centerline of road going East - Northeast and the centerline of road going North is 15 feet West and the centerline of road going South is 2 feet West and the condition of the recorded witnesses are: #1 thru #3 gone, #4 good condition, #5 and #6 gone, #7 thru #10 good condition.

C. DESCRIPTION OF MONUMENT FOR CORNER AND ACCESSORIES ESTABLISHED TO PERPETUATE LOCATING THE POSITION OF THE CORNER:

Removed 2½" X ¾" Sleigh Shoe and set a 4" diameter Harrison cast iron monument 20" long marked "County Surveyor" as a substantial marker for the section corner and is accepted as a careful and faithful reestablishment of the original corner.


36" Black Oak S71½°W 70.45' Found spike in Southeast side of tree. #4 22" White Pine N41°W 75.46' Set spike in Northeast side of tree. #7 ½" Iron and cap #30389 East 147.24' #8 Fence Post with 9" cap S42°W 54.62' Top center. #9 10"-18" Twin Maple N68°W 100.98' Found spike and tag #30389 in Northeast side of tree. #10

Signed by Norman L. Ochs Date October 17, 1996

Surveyor's Michigan License No. 22439

Form approved by Michigan State Board of Land Surveyors, Jan 28, 1971 Revised May 14, 1975 Revised Jan., 1983

Approved by Peer Review Group On October 24, 1996 Norman L. Ochs, County Representative.

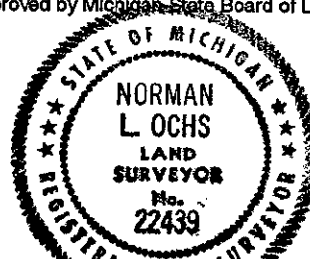

M.L.O.