

**SURVEY &
REMONUMENTATION**

APR 24 1995 NEWAYGO COUNTY REMONUMENTATION PROJECT

VOL 001 PAGE 101

COMMISSION

LAND CORNER RECORDATION CERTIFICATE
Filing Requirement of Act 74, Mich. P.A. 1970

For corners in

| | | |
|---|---------------------------|---------------------------|
| <u>Newaygo</u> <small>(County)</small> | Located In: | Corner Code ## |
| 1. Public Land Survey | T <u>13N</u> R <u>11W</u> | K-1 |
| | T _____ R _____ | _____ |
| | T _____ R _____ | _____ |
| | T _____ R _____ | _____ |
| 2. Property Controlling in Section | S _____ T _____ R _____ | _____ |
| | S _____ T _____ R _____ | _____ |
| 3. Miscellaneous Property in Sec. | S _____ T _____ R _____ | _____ |
| | S _____ T _____ R _____ | _____ |

NEWAYGO COUNTY
REGISTER OF DEEDS
MARLENE TOOGOOD

'95 MAR 14 PM 3 55

Marlene Toogood
Register of Deeds Stamp & File Number

4. Lot No. _____, Recorded Plat _____
5. Private Claims _____

| | | | | | | | | | | | |
|----|----|----|----|----|----|----|---|---|---|---|---|
| A | B | C | D | E | F | G | H | I | J | K | L |
| 2 | 6 | 5 | 4 | 3 | 2 | 1 | | | | | |
| 3 | | | | | | | | | | | |
| 4 | 7 | 8 | 9 | 10 | 11 | 12 | | | | | |
| 5 | | | | | | | | | | | |
| 6 | 18 | 17 | 16 | 15 | 14 | 13 | | | | | |
| 7 | | | | | | | | | | | |
| 8 | 19 | 20 | 21 | 22 | 23 | 24 | | | | | |
| 9 | | | | | | | | | | | |
| 10 | 30 | 29 | 28 | 27 | 26 | 25 | | | | | |
| 11 | | | | | | | | | | | |
| 12 | 31 | 32 | 33 | 34 | 35 | 36 | | | | | |
| 13 | | | | | | | | | | | |

I, Norman L. Ochs, in a field survey on December 14, 1994, do hereby certify that under requirements of P.A. 74, Michigan P.A. of 1970, the corner points mentioned in lines 1 and 2 above were in conformance with regulations and rules therefore as required in the current manual of survey instructions of the United States Department of the Interior, Bureau of Land Management or by a decree of a Court of Law and/or that the corner points mentioned in lines 3, 4 and 5 above were in conformance with the rules of the Michigan Board of Land Surveyors or by a Decree of a Court of Law; established, re-established, monumented, re-monumented, recovered, found as expressed below:

NOTE: Not more than 4 corners, all in the same town and range, may be recorded on this certificate.

N.W. Corner, Section 1, Big Prairie Twp., Newaygo Co., MI

A. Description of original monument and accessories and/or subsequent restoration:

- | | |
|--------------------------------------|--|
| G.L.O. John Hodgson 1837 | Lyle S. Shepherd R.L.S. #503 1920's |
| 24" Pine S47°W 11 lks. (7.26') #1 | 14" W. Pine S03 1/2°E .94 ch. (62.04') #3 |
| 10" W. Oak S57°E 48 lks. (31.68') #2 | 12" B. Oak N14 1/2°E .64 ch. (42.24') #4 |
| | 24" P. Stump S47°W .11 ch. (7.26') #5 |
| | 10" W. Oak Stump S57°E .57 ch. (37.62') #6 |


Did section break for Consumers Power Co. Drawing No. 164-P-1343-3E14. He found two (2) U.S. witnesses and set a tile. He measured 40.10 1/2 ch. (2646.93 feet) from the N.W. Cor. to the N. 1/4 Cor. of Sec. 1 and measured 40.25 1/2 ch. (2656.83 feet) from the N.W. Cor. to the W. 1/4 Cor. of Sec. 1.

B. Description of corner evidence found and/or method applied in restoring or reestablishing corner:

Found a 1/2" pipe in monument box and the condition of recorded witnesses are: #1 thru #10 Gone, #11 Good Condition, #12 Gone, #13 Thru #18 Good Condition.

C. Description of monument for corner and accessories established to perpetuate locating the position of the corner:

Removed 1/2" pipe and set a 4" Harrison Cast Iron Monument 20" long marked "County Surveyor" as a substantial marker for the section corner and is accepted as a careful and faithful reestablishment of the original corner.
 12" R. B. Oak S52°W 72.18' Spike in Southerly side of tree #11
 4"-10" Clump Maple S60°W 74.80' Spike in Northwest side of tree #13
 Power Pole N30°E 79.17' Spike in West side of pole #14
 12"-14" Tw. B. Oak S50°E 95.52' Spike in North side of tree #15
 Power Pole S30°W 54.16' Spike in West side of tree #16
 16" R. Oak S50°W 98.16' Spike in S.E. side of tree #17
 Found 1/2" Pipe, S.W. Cor. of Sec. 36, Goodwell Twp. East 33.22' #18

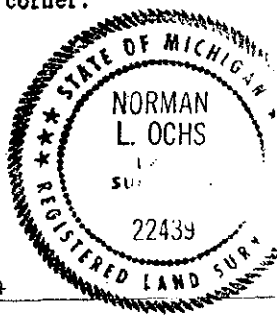

Signed by Norman L. Ochs Date December 15, 1994

Surveyor's Michigan License No. #22439

Accepted by Peer Review Group on December 15, 1994

Norman L. Ochs, County Representative. *N.L.O.*

A. Description.....(Continued)

N.C.R.C. Sheet Tile filled with concrete

12" B. Oak N14°E 42.2' #7

8" B. Oak S80°E 85.0' #8

S.W. Cor., Sec. 36 Goodwell Twp. East 33.00' #18

Measured 2656.80 feet from the N.W. Cor. to the W. 1/4 Cor. of Sec. 1 and measured 2621.3 feet from the N.E. Cor. to the N. 1/4 Cor. of Sec. 2.

C.F. Zimmerman P.E.

November 1958

Measured 2656.80 feet from the N.E. Cor. to the E. 1/4 Cor. of Sec. 2 and measured 2588.30 feet from the N.E. Cor. to the N. 1/4 Cor. of Sec. 2.

Patrick A. Salisbury R.L.S. 13594

July 17, 1973

Found Tile filled with Concrete

14"-10" Tw. B. Oak N14°E 42.25' #9

12"-10" Tw. Oak S70°E 86.00' #10

12" R. B. Oak S52°W 72.18' #11

Cable Marker S54°W 44.00' #12

Newaygo Engineering and Survey Co. January 13, 1980

1/2" Pipe in Monument Box

3"-6" Maple S60°W 74.83' #13

P. Pole N30°E 79.17' #14

12"-14" Tw. B. Oak S50°E 95.59' #15

P. Pole S30°W 53.65' #16

James J. Keller R.L.S. #10693 May 1989

Measured 2644.58 feet from the N.W. Cor. to the N. 1/4 Cor. of Sec. 1.

Newaygo Engineering and Survey Co. October 1993

Found 1/2" Pipe in Monument Box

16" R. Oak S50°W 98.62' Spike in S.E. side of tree #17

S.W. Corner Sec. 36, Goodwell Twp. East 33.25' #18

Measured 2644.71 feet from the N.W. Cor. to the N. 1/4 Cor. of Sec. 1 and measured 2650.53 feet from the N.W. Cor. to the W. 1/4 Cor. of Sec. 1.