

SURVEY & REMONUMENTATION

APR 24 1995 1994 NEWAYGO COUNTY REMONUMENTATION PROJECT

COMMISSION LAND CORNER RECORDATION CERTIFICATE
Filing Requirement of Act 74, Mich. P.A. 1970

VOL **001** PAGE **103**

For corners in

<u>Newaygo</u> <small>(County)</small>	Located In:	Corner Code #
1. Public Land Survey	T <u>13N</u> R <u>11W</u>	<u>L-1</u>
	T _____ R _____	_____
	T _____ R _____	_____
	T _____ R _____	_____
2. Property Controlling in Section	S _____ T _____ R _____	_____
	S _____ T _____ R _____	_____
3. Miscellaneous Property in Sec.	S _____ T _____ R _____	_____
	S _____ T _____ R _____	_____

NEWAYGO COUNTY
REGISTER OF DEEDS
MARLENE TOOGOOD

'95 MAR 14 PM 3 55

Register of Deeds Stamp & File Number
M. L. Ochs

4. Lot No. _____, Recorded Plat _____
5. Private Claims _____

	A	B	C	D	E	F	G	H	I	J	K	L
2	6	5	4	3	2	1						
3												
4	7	8	9	10	11	12						
5												
6	18	17	16	15	14	13						
7												
8	19	20	21	22	23	24						
9												
10	30	29	28	27	26	25						
11												
12	31	32	33	34	35	36						

I, Norman L. Ochs, in a field survey on December 14, 1994, do hereby certify that under requirements of P.A. 74, Michigan P.A. of 1970, the corner points mentioned in lines 1 and 2 above were in conformance with regulations and rules therefore as required in the current manual of survey instructions of the United States Department of the Interior, Bureau of Land Management or by a decree of a Court of Law and/or that the corner points mentioned in lines 3, 4 and 5 above were in conformance with the rules of the Michigan Board of Land Surveyors or by a Decree of a Court of Law; established, re-established, monumented, re-monumented, recovered, found as expressed below:

NOTE: Not more than 4 corners, all in the same town and range, may be recorded on this certificate.

N. 1/4 Corner, Section 1, Big Prairie Twp., Newaygo Co., MI

A. Description of original monument and accessories and/or subsequent restoration:

G.L.O. None

Lyle S. Shepherd R.L.S. #503 1920's
Prorated and Set Tile

Lyle S. Shepherd R.L.S. #503

Boulder N43 3/4°W .50 ch. (33.00') #3

Found 4" Sq. Pine Root Stake

Boulder N61 3/4°E .76 1/4 ch. (50.33') #4

10" B. Oak N28 1/2°W 70.4 lks. (46.46') #1

Boulder S32.1/2°E .56 3/4 ch. (35.48') #5

12" W. Pine S26°W 104.5 lks. (68.97') #2

Measured 4.10 1/2 ch. (2646.93 feet) from the N. 1/4 Cor. to the N.E.

May 15, 1926

Cor. of Sec. 1 and measured 40.10 1/2 ch. (2646.93 feet) from the N.

Book 59A Page 20

1/4 Cor. to the N.W. Cor. of Sec.1.

OVER----->

B. Description of corner evidence found and/or method applied in restoring or reestablishing corner:

Found 3/4" Pipe raised with a 1/2" Rod in monument box and the condition of recorded witnesses are: #1 thru #5 Gone, #6 Good Condition, #7 Gone #8 Gone, #9 and #10 Good Condition.

C. Description of monument for corner and accessories established to perpetuate locating the position of the corner:


Removed 3/4" Pipe and 1/2" Rod and set a 2 1/2" Harrison Cast Iron Monument 20" long marked "County Surveyor" as a substantial marker for the section corner and is accepted as a careful and faithful reestablishment of the original corner.

Power Pole N34°E 81.19' Spike in East side of pole #6

6" Ash S16°W 63.77' Spike in East side of tree #9

S. 1/4 Corner, Section 36, Goodwell Twp. East 16.08' #10 (1/2" Pipe in Monument Box)

N.W. Corner Steel Fence Post S55°E 56.90' #11

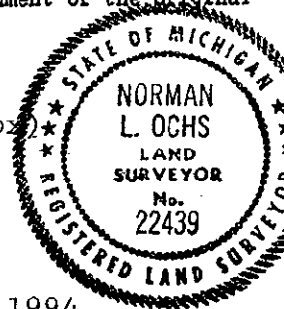

Signed by Norman L. Ochs Date December 15, 1994

Surveyor's Michigan License No. #22439

Approved by Peer Review Group on December 15, 1994

Norman L. Ochs, County Representative *N.L.O.*

A. Description....(Continued)

N.C.R.C. Sheet

Tile filled with concrete

P.Pole N40°E 81.0' #6

Fence Post South 21.80' #7

James J. Keller R.L.S. #10693 1984

Measured 2644.58 feet from the N.W. Cor. to the N. 1/4 Cor. of Sec. 1 and measured 2647.46 feet from the N. 1/4 Cor. to the N.E. Cor. of Sec. 1.

Newaygo Engineering and Survey Co.

October 1993

Found 3/4" Pipe raised with 1/2" Rod in monument box

S.E. Cor.-steel fence post N37°W 81.21' #8

P. Pole N34°E 81.21' #6

6" Ash S16°W 63.90' #9

S. 1/4 Cor. of Sec. 36, T14N R11W, East 16.11' #10

Measured 2644.71 feet from the N.W. Cor. to the N. 1/4 Cor. of Sec. 1 and measured 2646.5 feet from the N. 1/4 Cor. to the N.E. Cor. of Sec. 1.