

**SURVEY & REMONUMENTATION**

MAR 19 1998

1997 Newaygo County Remonumentation Project

NEWAYGO COUNTY REGISTER OF DEEDS  
LINDA M. BROWN

SECTION

LAND CORNER RECORDATION CERTIFICATE  
FILING REQUIREMENT of Act 74, Mich. P.A. 1970

'98 MAR 6 PM 12 35

*Linda M. Brown*

For corners in Newaygo Located in: \_\_\_\_\_ Corner Code # \_\_\_\_\_  
(County)

1. Public Land Survey T 12N R 11W  
T 13N R 11W  
T \_\_\_\_\_ R \_\_\_\_\_  
T \_\_\_\_\_ R \_\_\_\_\_
2. Property Controlling in Section S \_\_\_\_\_ T \_\_\_\_\_ R \_\_\_\_\_  
S \_\_\_\_\_ T \_\_\_\_\_ R \_\_\_\_\_
3. Miscellaneous Property in Sec. S \_\_\_\_\_ T \_\_\_\_\_ R \_\_\_\_\_  
S \_\_\_\_\_ T \_\_\_\_\_ R \_\_\_\_\_
4. Lot No. \_\_\_\_\_, Recorded Plat \_\_\_\_\_
5. Private Claims \_\_\_\_\_

M-1  
M-13 ✓  
\_\_\_\_\_  
\_\_\_\_\_  
\_\_\_\_\_  
\_\_\_\_\_

VOL. 2

83

Register of Deeds Stamp & File Number

	A	B	C	D	E	F	G	H	I	J	K	L	M
1													
2	6	5	4	3	2	1							
3													
4	7	8	9	10	11	12							
5													
6	18	17	16	15	14	13							
7													
8	19	20	21	22	23	24							
9													
10	30	29	28	27	26	25							
11													
12	31	32	33	34	35	36							
13													

I, Norman L. Ochs, in a field survey on August 4, 1997, do hereby certify that under requirements of P. A. 74, Michigan P.A. of 1970, the corner points mentioned in lines 1 and 2 above were in conformance with regulations and rules therefore as required in the current manual of survey instructions of the United States Department of the Interior, Bureau of Land Management or by a decree of a Court of Law and/or that the corner points mentioned in lines 3, 4 and 5 above were in conformance with the rules of the Michigan Board of Land Surveyors or by a Decree of a Court of Law; established, re-established, monumented, re-monumented, recovered, found as expressed below.

Note: Not more than 4 corners, all in the same town and range, may be recorded on this certificate.

Northeast Corner, Section 1, Croton Township, Newaygo County, Michigan.  
Southeast Corner, Section 36, Big Prairie Township, Newaygo County, Michigan.

**A. DESCRIPTION OF ORIGINAL MONUMENT AND ACCESSORIES AND/OR SUBSEQUENT RESTORATION:**

G.L.O. John Hodgson 1837  
14" Pine S42½°W 143 Links (94.38') #1  
12" Pine N16¾°E 150 Links (99') #2

Lyle Shepherd's Book Number 2 Page 107  
Sleigh Shoe and Crockery  
18" Black Oak S59¼°W 50' #4  
6" White Pine N34°W 77.1' #5

U.S.F.S. Information and Mecosta County Road  
Commission Sleigh Shoe  
30" Black Oak N30°W 66.3' #3  
30" Black Oak S50°W 50.0' #4

OVER ↙


**B. DESCRIPTION OF CORNER EVIDENCE FOUND AND/OR METHOD APPLIED IN RESTORING OR REESTABLISHING CORNER:**

Found P.K. nail in center of 1½" Pipe over 1½" X 22" Iron pipe over sleigh shoe with crockery in the centerline of North and South road and the centerline of road going East is 2.5 feet South. The condition of the recorded witnesses are: #1 thru #3 gone, #4 stump, #5 and #6 gone, #7 stump, #8 gone, #9 good condition, #10 and #11 gone, #12 good condition, #13 gone, #14 good condition.

**C. DESCRIPTION OF MONUMENT FOR CORNER AND ACCESSORIES ESTABLISHED TO PERPETUATE LOCATING THE POSITION OF THE CORNER:**

Removed Iron pipes and set a 4" diameter Harrison cast iron monument 20" long on top of sleigh shoe and crockery marked "County Surveyor" as a substantial marker for the section corner and is accepted as a careful and faithful reestablishment of the original corner.

30" Black Oak Stump S65°W 50.59' Found nail with bottle cap on Southeast side of stump. #4  
32" Oak Stump N75°W 75.15' to face. #7  
¾" Pipe with cap inside (#12679) N85°W 33.10' #9  
18" Red Oak S71°W 76.00' Found nail in root in South side of tree. #12  
Power Pole N21°W 124.36' Found nail in Northeast side of pole. #14  
14" Black Oak N48°W 59.45' Found P.K. nail in Northeast side of tree.  
Power Pole S54°E 107.32' Set P.K. nail in Northeast side of tree.

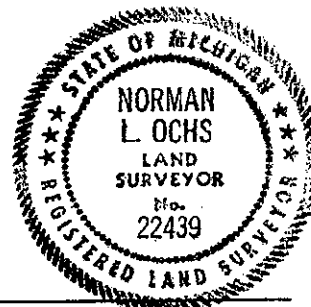

Signed by Norman L. Ochs Date September 8, 1997  
Norman L. Ochs

Surveyor's Michigan License No. 22439

Form approved by Michigan State Board of Land Surveyors, Jan 28, 1971  
Revised May 14, 1975  
Revised Jan., 1983

Approved by Peer Review Group on October 14, 1997  
Norman L. Ochs, County Representative.

*N. L. O.*

A. Description (cont.)

Douglas W. Bonnema R.L.S. #12579

July 12, 1974 LCRC #331 Found 1½" Iron at "X" checks with  
Previous witnesses.

18" Oak Northeast 74.91' #6

32" Oak West 75.23' #7

28" Oak Southwest 50.65' Nail is side. #4

Power Pole Southeast 105.04' #8

Newaygo Engineering and Survey Company

April 29, 1983 Found 1½" Iron

½" Rod and cap West 33.0' #9

William Fries, Jr. R.L.S. #30389

Found 1¼" Pipe outside diameter in occupied North and South and to East centerlines intersection. Pipe is 10 feet South of  
trail to the West. Pipe fits record accessories. LCRC #650 November 6, 1985

20" White Pine N39°E 122.68' #10

Power Pole S50°E 104.98' #11

18" Red Oak S65°W 75.97' #12

Red Oak N52°W 73.19' #13

Douglas W. Bonnema R.L.S. #12579

November 10, 1995 2" Pipe (P.K. in center) Recorded in Liber 363 Page 735

22" White Pine Northeast 122.48' #10

28" Oak Stump Southwest 50.55' #4

Power Pole Southeast 107.29' #8

Power Pole Northwest 124.32' #14