

SURVEY & REMONUMENTATION

MAR 19 1998

1997 Newaygo County Remonumentation Project

NEWAYGO COUNTY
REGISTER OF DEED
LINDA M. BROWN

'98 MAR 6 PM 12 3

SECTION

**LAND CORNER RECORDATION CERTIFICATE
FILING REQUIREMENT of Act 74, Mich. P.A. 1970**

Linda M. Brown

For corners in
Newaygo
(County)

Located in: _____ Corner Code # _____

1. Public Land Survey T 13N R 12W _____ C-1
T _____ R _____
T _____ R _____
T _____ R _____

2. Property Controlling S _____ T _____ R _____
in Section S _____ T _____ R _____

3. Miscellaneous S _____ T _____ R _____
Property in Sec. S _____ T _____ R _____

4. Lot No. _____, Recorded Plat _____

5. Private Claims _____

VOL. 2

93

Register of Deeds Stamp & File Number

| | A | B | C | D | E | F | G | H | I | J | K | L | M |
|----|----|---|----|---|----|---|----|---|----|---|----|---|---|
| 1 | | | | | | | | | | | | | |
| 2 | 6 | | 5 | | 4 | | 3 | | 2 | | 1 | | |
| 3 | | | | | | | | | | | | | |
| 4 | 7 | | 8 | | 9 | | 10 | | 11 | | 12 | | |
| 5 | | | | | | | | | | | | | |
| 6 | 18 | | 17 | | 16 | | 15 | | 14 | | 13 | | |
| 7 | | | | | | | | | | | | | |
| 8 | 19 | | 20 | | 21 | | 22 | | 23 | | 24 | | |
| 9 | | | | | | | | | | | | | |
| 10 | 30 | | 29 | | 28 | | 27 | | 26 | | 25 | | |
| 11 | | | | | | | | | | | | | |
| 12 | 31 | | 32 | | 33 | | 34 | | 35 | | 36 | | |
| 13 | | | | | | | | | | | | | |

I, Norman L. Ochs, in a field survey on October 2, 1997, do hereby certify that under requirements of P. A. 74, Michigan P.A. of 1970, the corner points mentioned in lines 1 and 2 above were in conformance with regulations and rules therefore as required in the current manual of survey instructions of the United States Department of the Interior, Bureau of Land Management or by a decree of a Court of Law and/or that the corner points mentioned in lines 3, 4 and 5 above were in conformance with the rules of the Michigan Board of Land Surveyors or by a Decree of a Court of Law; established, re-established, monumented, re-monumented, recovered, found as expressed below:

Note: Not more than 4 corners, all in the same town and range, may be recorded on this certificate.

Northeast Corner, Section 6, Everett Township, Newaygo County, Michigan.

A. DESCRIPTION OF ORIGINAL MONUMENT AND ACCESSORIES AND/OR SUBSEQUENT RESTORATION:

G.L.O. John H. Mullett 1837
18" Pine S12°W 60 Links (39.60') #1
24" Pine S23°E 48 Links (31.68') #2

Ralph A. Smith R.L.S. #3421
Found Axle Field Book 68B Page 17
26" Black Oak S45°W 80.0' #3
24" Black Oak N80°E 33.80' #4
Guy Pole S40°E 38.30' #5

William M. Jacques (County Surveyor)
Book 23 Page 40 1908
18" Pine S12°W 60 Links (39.60') #1
24" Pine S23°E 48 Links (31.68') #2

Newaygo Engineering and Survey Company
Power Pole S35°E 38.30' #6
Power Pole S30°W 38.66' #7
Southwest Corner, Section 32, T14N R12W, East 19.14' #8

OVER ↙

B. DESCRIPTION OF CORNER EVIDENCE FOUND AND/OR METHOD APPLIED IN RESTORING OR REESTABLISHING CORNER:

Found Railroad spike over a 30.5" Axle Rod 1" diameter. The centerline of the North and South bituminous road is 6 feet East and the centerline of bituminous road going West is 2 feet South and the centerline of gravel road going East is 2 feet South. The condition of the recorded witnesses are: #1 and #2 gone, #3 good condition, #4 and #5 gone, #6 thru #9 good condition.

C. DESCRIPTION OF MONUMENT FOR CORNER AND ACCESSORIES ESTABLISHED TO PERPETUATE LOCATING THE POSITION OF THE CORNER:

Removed Railroad spike and Axle rod and set a 4" Harrison cast iron monument 20" long marked "County Surveyor" as a substantial marker for the section corner and is accepted as a careful and faithful reestablishment of the original corner.

36" Black Oak S45°W 81.31' Found spike in Southeast side of tree. #3
Power Pole S35°E 38.30' Found spike in West side of pole. #6
Power Pole S45°W 38.68' Found spike in South side of pole. #7
Southwest Corner, Section 32, T14N R12W, (Harrison monument) East 19.20' #8
26" White Oak N53°E 80.63' Found spike in Northwest side of tree. #9

Signed by Norman L. Ochs Date October 7, 1997
Norman L. Ochs


Surveyor's Michigan License No. 22439

Form approved by Michigan State Board of Land Surveyors No. 22439-1971

Approved by Peer Review Group On October 14, 1997

Norman L. Ochs, County Representative.

N. L. O.

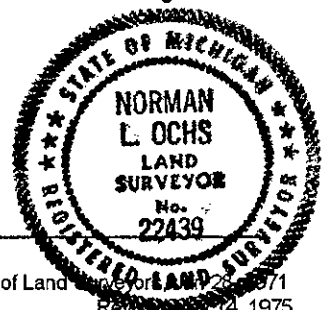

Revised July 14, 1975
Revised Jan., 1983

A. Description (cont.)

Newaygo Engineering and Survey Company

October 4, 1994 LCRC #1230

Found Railroad spike

Southwest Corner, Section 32, T14N R12W, East 19.14' #8

30" Black Oak S40°W 81.26' #3

Guy Pole S35°E 38.40' #5

Power Pole S30°W 39.67' #7

20" White Oak N40°E 80.59' #9