

**SURVEY & REMONUMENTATION**

MAR 02 1999

1998 Newaygo County Remonumentation Project

NEWAYGO COUNTY REGISTER OF DEEDS LINDA M. BROWN

LAND CORNER RECORDATION CERTIFICATE '99 FEB 17 PM 3 39 FILING REQUIREMENT of Act 74, Mich. P.A. 1970

**SECTION**

*Linda M. Brown*

For corners in Newaygo Located in: \_\_\_\_\_ Corner Code # \_\_\_\_\_  
 (County)

1. Public Land Survey T 13N R 12W \_\_\_\_\_ G-8 \_\_\_\_\_  
 T \_\_\_\_\_ R \_\_\_\_\_  
 T \_\_\_\_\_ R \_\_\_\_\_  
 T \_\_\_\_\_ R \_\_\_\_\_

2. Property Controlling S \_\_\_\_\_ T \_\_\_\_\_ R \_\_\_\_\_  
 in Section S \_\_\_\_\_ T \_\_\_\_\_ R \_\_\_\_\_  
 3. Miscellaneous S \_\_\_\_\_ T \_\_\_\_\_ R \_\_\_\_\_  
 Property in Sec. S \_\_\_\_\_ T \_\_\_\_\_ R \_\_\_\_\_

4. Lot No. \_\_\_\_\_, Recorded Plat \_\_\_\_\_  
 5. Private Claims \_\_\_\_\_

VOL. 2 229

Register of Deeds Stamp & File Number

	A	B	C	D	E	F	G	H	I	J	K	L	M
1													
2	6	5	4	3	2	1							
3													
4	7	8	9	10	11	12							
5													
6	18	17	16	15	14	13							
7													
8	19	20	21	22	23	24							
9													
10	30	29	28	27	26	25							
11													
12	31	32	33	34	35	36							
13													

I, Norman L. Ochs, in a field survey on November 27, 1998, do hereby certify that under requirements of P. A. 74, Michigan P.A. of 1970, the corner points mentioned in lines 1 and 2 above were in conformance with regulations and rules therefore as required in the current manual of survey instructions of the United States Department of the Interior, Bureau of Land Management or by a decree of a Court of Law and/or that the corner points mentioned in lines 3, 4 and 5 above were in conformance with the rules of the Michigan Board of Land Surveyors or by a Decree of a Court of Law, established, re-established, monumented, re-monumented, recovered, found as expressed below:

**Note: Not more than 4 corners, all in the same town and range, may be recorded on this certificate.**

East One Quarter Corner, Section 21, Everett Township Newaygo County, Michigan.

**A. DESCRIPTION OF ORIGINAL MONUMENT AND ACCESSORIES AND/OR SUBSEQUENT RESTORATION:**

G.L.O. J.H. Mullett 1837 8" Black Ash S10°W 17 Links (11.22') #1 10" Maple N08°E 15 Links (9.9') #2	Newaygo County Road Commission Sheet 1½" Pipe 20" Maple N60°E 44.7' #3 15" Maple S45°E 69.3' #4
Ralph A. Smith R.L.S. #3421 October 18, 1951 Book 70A, Page 44 1½" Gas Pipe 20" Maple (U.S.G.S. 847.5') N60°±E 44.7' #3 18" Maple S45°±E 69.1' #4	Ralph A. Smith R.L.S. #3421 1964 Book 70A, Page 62 1½" Pipe 20" Maple S60°E 44.7' #3 15" Maple S45°E 69.3' #4

OVER ↵

**B. DESCRIPTION OF CORNER EVIDENCE FOUND AND/OR METHOD APPLIED IN RESTORING OR REESTABLISHING CORNER:**

Found 4" diameter Harrison cast iron monument (too corroded to read) 2 inches ± below grade on line ± with the centerline of gravel road going East. The centerline of the North and South gravel road is 4 feet ± East and there is no apparent occupation going West (swamp). The condition of the recorded witnesses are: #1 and #2 gone, #3 stump, #4 good condition, #5 dead, #6 stump, #7 good condition, #8 poor condition.


**C. DESCRIPTION OF MONUMENT FOR CORNER AND ACCESSORIES ESTABLISHED TO PERPETUATE LOCATING THE POSITION OF THE CORNER:**

Accepted 4" diameter Harrison cast iron monument 36" long as a substantial marker for the section corner and is accepted as a careful and faithful reestablishment of the original corner.

30" ± diameter Stump (mostly decayed) N66°E 45.5' ± to center. #3  
 30" Maple (blazed) S38°E 69.75' Found spike in Northeast side of tree. #4  
 18" Maple (dead) N80°W 30.75' Found spike in North side of tree. #5  
 14" Stump S33°W 46.43' Found spike in Westerly side of stump. #6  
 10" Maple (blazed) S48°W 32.50' Found spike in Southeasterly side of tree. #7  
 10" diameter Wood Post (in poor condition) N40°W 41.80' Found spike in Northeasterly side of post. #8  
 10" Ash (blazed) N13°W 62.85' Set spike and tag #22439 in Easterly side of tree.  
 4" ash N69°E 62.00' Set spike with tag #22439 in South side of tree.

Signed by Norman L. Ochs Date December 4, 1998  
 Norman L. Ochs  
 Surveyor's Michigan License No. 22439 Form approved by Michigan State Board of Land Surveyors

Approved by Peer Review Group On December 22, 1998  
 Norman L. Ochs, County Representative.

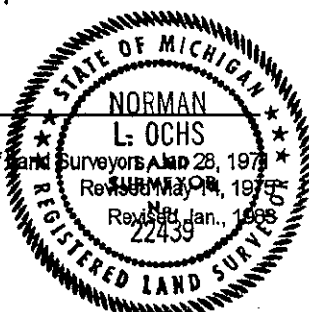

*N.L.O.*

A. Description (cont.)

Patrick A. Salisbury R.L.S. #13594  
July 10, 1972 Found 1½" Pipe raised with ½" Rod  
20" Maple N60°E 44.7' #3  
15" Maple S45°E 69.3' #4  
12" Maple N80°W 30.82' #5

Sammy S. Barnett R.L.S. #16923  
May 24, 1973 LCRC #216 Found ½" Rerod  
12" Maple S33°W 46.45' #6  
14" Maple N80°W 30.79' #5  
30" Maple N66°E 45.18' #3

Norman L. Ochs R.L.S. #22439  
October 19, 1986 LCRC #795  
Found 1½" Pipe raised with ½" Rod also found tile and 2 wood stakes. Removed and set a 4" Harrison cast iron monument  
36" long marked "County Surveyor"  
16" Maple S45°E 69.73' #4  
12" Maple N80°W 30.74' #5  
Corner Fence Post N45°W 41.84' #8  
5" Maple S40°W 32.53' #7  
12" Maple S25°W 46.48' #6

SURVEY &  
REMONUMENTATION

MAR 02 1989

SECTION