

MAR 02 1999

1998 Newaygo County Remonumentation Project

NEWAYGO COUNTY REGISTER OF DEEDS LINDA M. BROWN

'99 FEB 17 PM 3 39

LAND CORNER RECORDATION CERTIFICATE FILING REQUIREMENT of Act 74, Mich. P.A. 1970

SECTION

For corners in Newaygo (County) Located in: Corner Code #

1. Public Land Survey T 13N R 12W K-1

2. Property Controlling in Section S T R

3. Miscellaneous Property in Sec. S T R

4. Lot No. \_\_\_\_\_, Recorded Plat \_\_\_\_\_

5. Private Claims \_\_\_\_\_

*Linda M. Brown*

VOL. 2 231

Register of Deeds Stamp & File Number

	A	B	C	D	E	F	G	H	I	J	K	L	M
1													
2	6	5	4	3	2	1							
3													
4	7	8	9	10	11	12							
5													
6	18	17	16	15	14	13							
7													
8	19	20	21	22	23	24							
9													
10	30	29	28	27	26	25							
11													
12	31	32	33	34	35	36							
13													

I, Norman L. Ochs, in a field survey on October 26, 1998, do hereby certify that under requirements of P. A. 74, Michigan P.A. of 1970, the corner points mentioned in lines 1 and 2 above were in conformance with regulations and rules therefore as required in the current manual of survey instructions of the United States Department of the Interior, Bureau of Land Management or by a decree of a Court of Law and/or that the corner points mentioned in lines 3, 4 and 5 above were in conformance with the rules of the Michigan Board of Land Surveyors or by a Decree of a Court of Law; established, re-established, monumented, re-monumented, recovered, found as expressed below:

Note: Not more than 4 corners, all in the same town and range, may be recorded on this certificate.

Northwest Corner, Section 1, Everett Township, Newaygo County, Michigan.

A. DESCRIPTION OF ORIGINAL MONUMENT AND ACCESSORIES AND/OR SUBSEQUENT RESTORATION:

G.L.O. John Hodgson 1837  
12" Black Ash S30°E 22 Links (14.52') #1  
10" Black Ash S26°W 17 Links (11.22') #2  
Set Post, Southwest Corner, Section 36, T14N R12W, East 18 Links (11.88') #10

Newaygo County Road Commission Sheet Iron  
8" Hemlock N60°E 64.8' #3  
10" Basswood N66°W 66.7' #4  
Head wall S36°W 21.9' #5  
Head wall S31°E 21.3' #6

Ralph A. Smith R.L.S. #3421  
Witness Book No. 2, Page 2 1958 Iron  
8" Hemlock N60°E 64.8' #3  
10" - 4" Basswood N66°W 66.7' #4  
Head wall S36°W 21.9' #5  
Head wall S31°E 21.3' #6

Norman L. Ochs R.L.S. #22439  
July 2, 1982 Found 1/2" Pipe Drawing Number 82030B  
28" White Oak S16°E 84.05' #7  
14" - 12" Twin Basswood N65°W 66.15' #4  
10" - 12" Clump Basswood (Southerly tree) N47°E 66.85' #8  
Southwest Corner, Section 36, T14N R12W, East 11.88' #9

B. DESCRIPTION OF CORNER EVIDENCE FOUND AND/OR METHOD APPLIED IN RESTORING OR REESTABLISHING CORNER:

Found 1/2" X 18" Rerod with cap (illegible) on line ± with the centerline of the East and West bituminous road and on line with the centerline of the bituminous road going South. The condition of the recorded witnesses are: #1 thru #4 gone, #5 and #6 has been replaced with Corrugated Metal Pipe, #7 good condition, #8 gone, #9 good condition.

C. DESCRIPTION OF MONUMENT FOR CORNER AND ACCESSORIES ESTABLISHED TO PERPETUATE LOCATING THE POSITION OF THE CORNER:


Removed Rerod and set a 2 3/4" X 20" Harrison cast iron monument marked "County Survey" in a new 8" diameter monument box as a substantial marker for the section corner and is accepted as a careful and faithful reestablishment of the original corner.

36" White Oak S19°E 85.04' Found spike in West side of tree. #7  
Southwest Corner, Section 36, T14N R12W, East 11.79' #9  
10" Hemlock (blazed) N55°W 84.55' Set spike with tag #22439 in South side of tree.  
12" Maple N17°E 69.47' Set spike with tag #22439 in West side of tree.  
10" White Pine S29°W 62.31' Set spike with tag #22439 in Northwesterly side of tree.

Signed by Norman L. Ochs Date November 3, 1998  
Norman L. Ochs

Surveyor's Michigan License No. 22439

Form approved by Michigan State Board of Land Surveyors, 1971

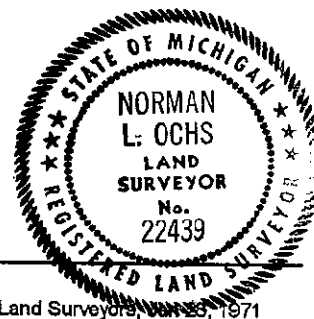

Approved by Peer Review Group on December 8, 1998  
Norman L. Ochs, County Representative.

Revised May 14, 1975  
Revised Jan., 1983

*N.L.O.*