

SURVEY & REMONUMENTATION

MAR 19 1998

1997 Newaygo County Remonumentation Project

NEWAYGO COUNTY REGISTER OF DEEDS
LINDA M. BROWN

'98 MAR 6 PM 12 35

Linda M. Brown

SECTION

**LAND CORNER RECORDATION CERTIFICATE
FILING REQUIREMENT of Act 74, Mich. P.A. 1970**

For corners in <u>Newaygo</u> (County)	Located in:	Corner Code #
1. Public Land Survey	T <u>13N</u> R <u>13W</u>	<u>A-2</u> ✓
	T <u>13N</u> R <u>14W</u>	<u>M-2</u>
	T ___ R ___	_____
	T ___ R ___	_____
2. Property Controlling in Section	S ___ T ___ R ___	_____
	S ___ T ___ R ___	_____
3. Miscellaneous Property in Sec.	S ___ T ___ R ___	_____
	S ___ T ___ R ___	_____
4. Lot No. _____, Recorded Plat _____		
5. Private Claims _____		

VOL. 2

89

Register of Deeds Stamp & File Number

	A	B	C	D	E	F	G	H	I	J	K	L	M
1													
2	6	5	4	3	2	1							
3													
4	7	8	9	10	11	12							
5													
6	18	17	16	15	14	13							
7													
8	19	20	21	22	23	24							
9													
10	30	29	28	27	26	25							
11													
12	31	32	33	34	35	36							
13													

I, Norman L. Ochs, in a field survey on October 13, 19 97, do hereby certify that under requirements of P. A. 74, Michigan P.A. of 1970, the corner points mentioned in lines 1 and 2 above were in conformance with regulations and rules therefore as required in the current manual of survey instructions of the United States Department of the Interior, Bureau of Land Management or by a decree of a Court of Law and/or that the corner points mentioned in lines 3, 4 and 5 above were in conformance with the rules of the Michigan Board of Land Surveyors or by a Decree of a Court of Law, established, re-established, monumented, re-monumented, recovered, found as expressed below.

Note: Not more than 4 corners, all in the same town and range, may be recorded on this certificate.

West One Quarter Corner, Section 6, Sherman Township, Newaygo County, Michigan.
East One Quarter Corner, Section 1, Dayton Township, Newaygo County, Michigan.

A. DESCRIPTION OF ORIGINAL MONUMENT AND ACCESSORIES AND/OR SUBSEQUENT RESTORATION:

G.L.O. Mullett and Brookfield 1838
9" Sugar S17°W 14 Links (9.24') #1
8" Hemlock N57°W 20 Links (13.20') #2

Newaygo County Road Commission Sheet
Pine Stump N69°E 41.5' #5
Pine Stump N22°W 24' #6

County Surveyor's Witness Book Page 168
12" Elm S65½°W 51½' #3
Badge Hedge Fence 2 rods (33') North #4

Patrick A. Salisbury R.L.S. #13594
Consumers Power Company Section Break March 1968
Set half way on line. Set 1" Pipe 2 feet West of the West edge of road.
Corner Fence Post N50°W 9.25' #7
Fence Post N50°E 47.15' #8
Telephone Pole S15°W 108.15' #9

OVER ↙

B. DESCRIPTION OF CORNER EVIDENCE FOUND AND/OR METHOD APPLIED IN RESTORING OR REESTABLISHING CORNER:


Found nothing. Set 4" diameter Harrison cast iron monument 20" long marked "County Surveyor" equal distance and on line between the Northwest Corner and the Southwest Corner, per Patrick A. Salisbury and G.L.O. The centerline of the North and South paved road is 13 feet East. The centerline of drive going West is 15 feet South. The centerline of fence going West is 4.38 feet North. The condition of the recorded witnesses are: #1 thru #9 gone, #10 flat on ground, #11 and #12 good condition.

C. DESCRIPTION OF MONUMENT FOR CORNER AND ACCESSORIES ESTABLISHED TO PERPETUATE LOCATING THE POSITION OF THE CORNER:

Accepted 4" diameter Harrison cast iron monument 20" long marked "County Surveyor" as a substantial marker for the section corner and is accepted as a careful and faithful reestablishment of the original corner.

½" Rerod with cap # JHM 27456" N82°W 33.03' #11
½" Rerod with cap # JHM 27456" S50°W 46.32' #12
Power Pole N88°W 46.65' Set spike and tag in South side of pole.
Fence Post N70°E 53.48' Set spike and tag in North side of tree.
North end of Corrugated Metal Pipe Culvert 12" N15°W 20.02' Top centerline at end.

Signed by Norman L. Ochs Date October 14, 1997
Surveyor's Michigan License No. 22439

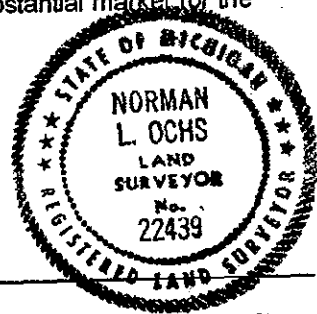

Approved by Peer Review Group on October 14, 1997
Norman L. Ochs, County Representative.

N.L.O.

Form approved by Michigan State Board of Land Surveyors, Jan 28, 1971
Revised May 14, 1975
Revised Jan., 1983