

**SURVEY &
REMONUMENTATION**

APR 24 1995 1994 NEWAYGO COUNTY REMONUMENTATION PROJECT
LAND CORNER RECORDATION CERTIFICATE

COMMISSION

Filing Requirement of Act 74, Mich. P.A. 1970

VOL. 001 PAGE 112

For corners in

<u>Newaygo</u> (County)	Located in:	Corner Code #
1. Public Land Survey	T <u>13N</u> R <u>13W</u>	<u>B-5</u>
	T _____ R _____	_____
	T _____ R _____	_____
	T _____ R _____	_____
2. Property Controlling in Section	S _____ T _____ R _____	_____
	S _____ T _____ R _____	_____
3. Miscellaneous Property in Sec.	S _____ T _____ R _____	_____
	S _____ T _____ R _____	_____

NEWAYGO COUNT
REGISTER OF DEEDS
MARLENE TOOGOO

'95 MAR 14 PM 3

Register of Deeds *Books & File Number* *Page*

4. Lot No. _____, Recorded Plat _____
5. Private Claims _____

	A	B	C	D	E	F	G	H	I	J	K	L
2	6	5	4	3	2	1						
3												
4	7	8	9	10	11	12						
5	•											
6	18	17	16	15	14	13						
7												
8	19	20	21	22	23	24						
9												
10	30	29	28	27	26	25						
11												
12	31	32	33	34	35	36						
13												

I, Norman L. Ochs, in a field survey on November 30, 1994, do hereby certify that under requirements of P.A. 74, Michigan P.A. of 1970, the corner points mentioned in lines 1 and 2 above were in conformance with regulations and rules therefore as required in the current manual of survey instructions of the United States Department of the Interior, Bureau of Land Management or by a decree of a Court of Law and/or that the corner points mentioned in lines 3, 4 and 5 above were in conformance with the rules of the Michigan Board of Land Surveyors or by a Decree of a Court of Law; established, re-established, monumented, re-monumented, recovered, found as expressed below:

NOTE: Not more than 4 corners, all in the same town and range, may be recorded on this certificate.

N. 1/4 Corner, Section 18, Sherman Twp., Newaygo Co., MI

A. Description of original monument and accessories and/or subsequent restoration:

G.L.O. John Mullett 1838 Delos G. Anderson (Co. Surveyor) Book A Page 149
10" Beech N26°E 14 lks. (9.24') #1 August 18, 1897 Old stake found by Sam Odell, Iron fire grate and stone set.
10" Beech S35°E 15 lks. (9.90') #2

Delos G. Anderson (Co. Surveyor) OVER----->
Book A Page 149 1895
Established 30" P. Stp. N42°E 42 lks. (27.72') #3 Measured 39.58 chains (2612.28 feet) from the N.E. Cor. to the N. 1/4 Cor. of Sec. 18 and measured 40.10 1/2 chains (2646.93 feet) from the N. 1/4 Cor. to the C. 1/4 Cor. of Sec. 18 and measured 38.07 chains (2512.16 feet) from the N. 1/4 Cor. to the N.W. Cor. of Sec. 18.


B. Description of corner evidence found and/or method applied in restoring or reestablishing corner:

Found a Big Rock and fire grate and small rocks around bottom. The centerline of the East and West gravel road is 7 feet South and measured 2523.16 feet from the N.W. Cor. to the N. 1/4 Cor. of Sec. 18 and measured 2591.93 feet from the N. 1/4 Cor. to the N.E. Cor. of Sec. 18 and the condition of recorded witnesses are: #1 thru #3 Gone, and the witnesses #4 thru #7 were to a 1" pipe as set by Patrick A. Salisbury in 1968. Patrick A. Salisbury did not find the 1897 stone and iron fire grate that was set by Delos G. Anderson. I feel that we have recovered the true position of the corner as set by Delos G. Anderson. Also note that there are some very big hills in this mile, this would explain our distances as being somewhat different than previous surveyors.

C. Description of monument for corner and accessories established to perpetuate locating the position of the corner:

Removed Big Stone and fire grate and set a 4" dia. Harrison Cast Iron Monument 20" long marked "County Surveyor" as a substantial marker for the section corner and is accepted as a careful and faithful reestablishment of the original corner.

12"-16" R. Oak South 28.22' Spike on East side of tree
8" Poplar S20°W 47.39' Spike in West side of tree
6" R. Pine N30°W 58.83' Spike in Southwest side of tree
6" R. Pine N40°E 54.50' Spike in Southwest side of tree

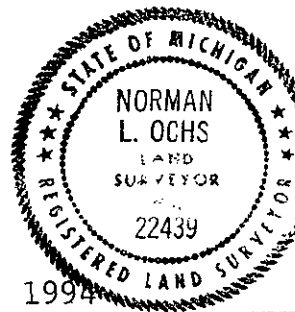

Signed by Norman L. Ochs Date November 30, 1994
Surveyor's Michigan License No. #22439

Approved by Peer Review Group on December 1, 1994
Norman L. Ochs, County Representative. *N.L.O.*

A. Description.....(Continued)

Delos G. Anderson Book A Pages 211 and 212

September 20, 1897

Measured 37.36 chains (2465.76 feet) from the S.W. Cor. to the S. 1/4 Cor. of Sec. 7 and measured 39.36 chains (2597.76 feet) from the S. 1/4 Cor. to the C. 1/4 Cor. of Sec. 7.

William M. Jacques (Co. Surveyor) Field Book 10 Page 48

May 31, 1904

Measured 38 chains 30 3/4 feet (2538.75 feet) from the N.W. Cor. to the N. 1/4 Cor. of Sec. 18.

Patrick A. Salisbury R.L.S. #13594

July 1968 Section break for Consumers Power Co. Drawing No. S-F17051

Set 1" Pipe proportioned to Government Survey on a straight line between the N.W. and the N.E. Corners of Sec. 18.

Centerline of Road North 33.4' #4

12" R. Oak N45°W 15.3' #5

4" Poplar N40°W 11.25' #6

5" Poplar S05°E 6.60' #7

Measured 2508.40 feet from the S.W. Cor. to the S. 1/4 Cor. of Sec. 7 and measured 2628.92 feet from the S. 1/4 Cor. to the C. 1/4 Cor. of Sec. 7 and measured 2606.13 feet from the S. 1/4 Cor. to the S.E. Cor. of Sec. 7 and measured 2638.82 feet from the N. 1/4 Cor. to the C. 1/4 Cor. of Sec. 18.