

MAR 02 1999

1998 Newaygo County Remonumentation Project

LAND CORNER RECORDATION CERTIFICATE '99 FEB 17 PM 3 38 FILING REQUIREMENT of Act 74, Mich. P.A. 1970

SECTION

Linda M. Brown

For corners in Newaygo (County) Located in: Corner Code # 1. Public Land Survey T 13N R 13W J-1 2. Property Controlling in Section S T R 3. Miscellaneous Property in Sec. S T R

VOL. 2 220

Register of Deeds Stamp & File Number

4. Lot No. Recorded Plat 5. Private Claims

I, Norman L. Ochs, in a field survey on December 14, 1998, do hereby certify that under requirements of P. A. 74, Michigan P.A. of 1970, the corner points mentioned in lines 1 and 2 above were in conformance with regulations and rules therefore as required in the current manual of survey instructions of the United States Department of the Interior, Bureau of Land Management or by a decree of a Court of Law and/or that the corner points mentioned in lines 3, 4 and 5 above were in conformance with the rules of the Michigan Board of Land Surveyors or by a Decree of a Court of Law; established, re-established, monumented, re-monumented, recovered, found as expressed below:

Grid table with columns A-L and rows 1-13. Cell (2,6) contains '6', (2,7) contains '5', (2,8) contains '4', (2,9) contains '3', (2,10) contains '2', (2,11) contains '1'. Cell (4,1) contains '7', (4,2) contains '8', (4,3) contains '9', (4,4) contains '10', (4,5) contains '11', (4,6) contains '12'. Cell (6,1) contains '18', (6,2) contains '17', (6,3) contains '16', (6,4) contains '15', (6,5) contains '14', (6,6) contains '13'. Cell (8,1) contains '19', (8,2) contains '20', (8,3) contains '21', (8,4) contains '22', (8,5) contains '23', (8,6) contains '24'. Cell (10,1) contains '30', (10,2) contains '29', (10,3) contains '28', (10,4) contains '27', (10,5) contains '26', (10,6) contains '25'. Cell (12,1) contains '31', (12,2) contains '32', (12,3) contains '33', (12,4) contains '34', (12,5) contains '35', (12,6) contains '36'.

Note: Not more than 4 corners, all in the same town and range, may be recorded on this certificate.

North One Quarter Corner, Section 2, Sherman Township, Newaygo County, Michigan.

A. DESCRIPTION OF ORIGINAL MONUMENT AND ACCESSORIES AND/OR SUBSEQUENT RESTORATION:

G.L.O. Did not set.

Lyle S. Shepherd R.L.S. #503 October 27, 1926 Book 32, Page 32 Stone

Lyle S. Shepherd R.L.S. #503 September 8, 1923 Book 53, Pages 32 and 33 Buggy Axle, 3 stones and glass

Robert A. Griffin R.L.S. #13584 LCRC #453 August 6, 1977 Searched for but did not find evidence for this corner. I reestablished this corner equal distance and on a straight line between controlling corners. Set a 5" square by 36" concrete monument with brass cap Power Pole N76°E 121.37' #1 4" Red Pine N64°W 145.06' #2 Concrete monument (South One Quarter Corner, Section 35, T14N R13W) West 18.15' #3

B. DESCRIPTION OF CORNER EVIDENCE FOUND AND/OR METHOD APPLIED IN RESTORING OR REESTABLISHING CORNER:

Found 5" square concrete monument with brass cap on line with the centerline of the East and West dirt road. The condition of the recorded witnesses are: #1 thru #3 good condition.

C. DESCRIPTION OF MONUMENT FOR CORNER AND ACCESSORIES ESTABLISHED TO PERPETUATE LOCATING THE POSITION OF THE CORNER:

Accepted the 5" square concrete monument with brass cap as a substantial marker for the section corner and is accepted as the best available position for the location of this corner.


Power Pole N81°E 121.32' Found spike with tag #13584 in North side of pole. #1 12" Red Pine (blazed) N57°W 144.97' Found cabin spike in Northerly side of tree. #2 5" square concrete monument (South One Quarter Corner, Section 35, T14N R13W) West 18.48' #3 12" - 4" Twin Juniper N03°E 124.78' Set spike with tag #22439 in East side of tree. 10" - 10" Twin White Oak (blazed) S12°E 110.87' Set spike with tag #22439 in East side of tree.

Signed by Norman L. Ochs Date December 18, 1998

Surveyor's Michigan License No. 22439

Form approved by Michigan State Board of Land Surveyors, Jan 28, 1971 Revised May 14, 1975 Revised Jan., 1983

Approved by Peer Review Group on December 22, 1998 Norman L. Ochs, County Representative.

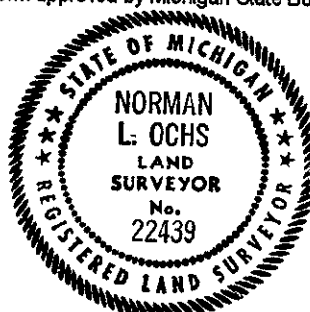

N.L.O.