

SURVEY & REMONUMENTATION

MAR 19 1998

1997 Newaygo County Remonumentation Project

NEWAYGO COUNTY REGISTER OF DEEDS LINDA M. BROWN

SECTION

LAND CORNER RECORDATION CERTIFICATE FILING REQUIREMENT of Act 74, Mich. P.A. 1970

'98 MAR 6 PM 12 35

Linda M. Brown

For corners in <u>Newaygo</u> (County)	Located in:	Corner Code #
1. Public Land Survey	T <u>13N</u> R <u>13W</u>	<u>J-9</u>
	T ___ R ___	_____
	T ___ R ___	_____
	T ___ R ___	_____
2. Property Controlling in Section	S ___ T ___ R ___	_____
	S ___ T ___ R ___	_____
3. Miscellaneous Property in Sec.	S ___ T ___ R ___	_____
	S ___ T ___ R ___	_____
4. Lot No. _____, Recorded Plat _____		
5. Private Claims _____		

VOL. 2

91

Register of Deeds Stamp & File Number

	A	B	C	D	E	F	G	H	I	J	K	L	M
1													
2	6	5	4	3	2	1							
3													
4	7	8	9	10	11	12							
5													
6	18	17	16	15	14	13							
7													
8	19	20	21	22	23	24							
9													
10	30	29	28	27	26	25							
11													
12	31	32	33	34	35	36							
13													

I, Norman L. Ochs, in a field survey on September 2, 1997, do hereby certify that under requirements of P. A. 74, Michigan P. A. of 1970, the corner points mentioned in lines 1 and 2 above were in conformance with regulations and rules therefore as required in the current manual of survey instructions of the United States Department of the Interior, Bureau of Land Management or by a decree of a Court of Law and/or that the corner points mentioned in lines 3, 4 and 5 above were in conformance with the rules of the Michigan Board of Land Surveyors or by a Decree of a Court of Law; established, re-established, monumented, re-monumented, recovered, found as expressed below.

Note: Not more than 4 corners, all in the same town and range, may be recorded on this certificate.

North One Quarter Corner, Section 26, Sherman Township, Newaygo County, Michigan.

A. DESCRIPTION OF ORIGINAL MONUMENT AND ACCESSORIES AND/OR SUBSEQUENT RESTORATION:

G.L.O. John Mullett 1836	Newaygo County Road Commission Sheet
18" Elm N68°W 21 Links (13.86')#1	Buggy Axle
4" Black Ash N33°E 8 Links (5.28')#2	30" Willow N37°W 32.8' #4
	6" Elm S06°E 32.8' #5
Placed Buggy Axle by U.S.D.A. (Mikel) 1936	
6" Oak Post South 25 Links (16.5')#3	

Norman C. Caldwell R.L.S. #12018
LCRC #1122 July 1991 (U.S.D.A. Forest Service)
No evidence of original or perpetuated monument. Placed 5" X 5" X 36" concrete monument with brass cap by extending line at double distance from Southeast Section Corner and East One Sixteenth Corner verified by line and section distances West to Southwest Corners and West One Sixteenth and is accepted as a careful and faithful reestablishment of the position of the original corner.
12" Aspen S77°W 50.29' #6
6" Elm N33°W 59.81' #7
12" Black Cherry N25°E 42.58' #8
24" Beech S76°E 142.07' #9
Carsonite Witness Post South 10.0' #10

B. DESCRIPTION OF CORNER EVIDENCE FOUND AND/OR METHOD APPLIED IN RESTORING OR REESTABLISHING CORNER:

Found U.S.D.A. Forest Service monument 1 foot under road bed. The centerline of the East and West gravel road is 7 feet North and the condition of the recorded witnesses are: #1 thru #5 gone, #6 thru #10 good condition.

C. DESCRIPTION OF MONUMENT FOR CORNER AND ACCESSORIES ESTABLISHED TO PERPETUATE LOCATING THE POSITION OF THE CORNER:

Accepted U.S.D.A. Forest Service monument as a substantial marker for the section corner and is accepted as a careful and faithful reestablishment of the original corner.

12" Poplar S75°W 50.22' Found spike and tag #12018 in Southeast side of tree. #6
12" Elm N33°W 59.80' Found spike and tag #12018 in Northeast side of tree. #7
12" Cherry N25°E 42.52' Found spike and tag #12018 in Southeast side of tree. #8
26" Beech S73°E 142.18' Found spike and tag #12018 in Northeast side of tree. #9
Carsonite Witness Post South 10.0' #10


Signed by Norman L. Ochs Date September 8, 1997

Surveyor's Michigan License No. 22439

Form approved by Michigan State Board of Land Surveyors, Jan 28, 1971

Revised May 14, 1975
Revised Jan., 1983

Approved by Peer Review Group on September 9, 1997
Norman L. Ochs, County Representative.

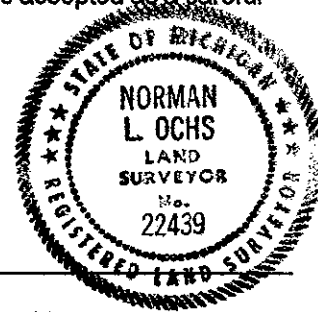

N. L. Ochs