

**MAR 1 9 2000**

**1999 Newaygo County Remonumentation Project**

**NEWAYGO COUNTY  
REGISTER OF DEEDS  
LYNDA H. BROWN**

**SECTION**

**LAND CORNER RECORDATION CERTIFICATE '00 FEB 28 PM 1 17  
FILING REQUIREMENT of Act 74, Mich. P.A. 1970**

*Linda M. Brown*

For corners in <u>Newaygo</u> (County)	Located in:	Corner Code #
1. Public Land Survey	T <u>13N</u> R <u>13W</u>	<u>K-3</u>
	T ___ R ___	_____
	T ___ R ___	_____
	T ___ R ___	_____
2. Property Controlling in Section	S ___ T ___ R ___	_____
	S ___ T ___ R ___	_____
3. Miscellaneous Property in Sec.	S ___ T ___ R ___	_____
	S ___ T ___ R ___	_____
4. Lot No. _____, Recorded Plat _____		
5. Private Claims _____		

**VOL. 2**

**345**

**Register of Deeds Stamp & File Number**

1	A	B	C	D	E	F	G	H	I	J	K	L	M
2	6	5	4	3	2	1							
3													
4	7	8	9	10	11	12							
5													
6	18	17	16	15	14	13							
7													
8	19	20	21	22	23	24							
9													
10	30	29	28	27	26	25							
11													
12	31	32	33	34	35	36							
13													

I, Norman L. Ochs, in a field survey on November 3, 1999, do hereby certify that under requirements of P. A. 74, Michigan P.A. of 1970, the corner points mentioned in lines 1 and 2 above were in conformance with regulations and rules therefore as required in the current manual of survey instructions of the United States Department of the Interior, Bureau of Land Management or by a decree of a Court of Law and/or that the corner points mentioned in lines 3, 4 and 5 above were in conformance with the rules of the Michigan Board of Land Surveyors or by a Decree of a Court of Law; established, re-established, monumented, re-monumented, recovered, found as expressed below.

**Note: Not more than 4 corners, all in the same town and range, may be recorded on this certificate.**

Northwest Corner, Section 12, Sherman Township, Newaygo County, Michigan.

**A. DESCRIPTION OF ORIGINAL MONUMENT AND ACCESSORIES AND/OR SUBSEQUENT RESTORATION:**

G.L.O. John Mullett 1838 10" Cedar S50°W 18 Links (11.88')#1 10" Cedar S58°E 13 Links (8.58')#2	David R. Greer R.L.S. #16047 June 2, 1972 LCRC #50 Set concrete monument 6" Ash S40°E 15.69' #3 6" Ash S45°E 14.11' #4 15" Maple S15°W 32.52' #5 6" Ash N85°E 5.42' #6
Patrick R. Leemon R.L.S. #31595 1988 Found 4" square concrete monument with 1/2" Rebar, corner is in marsh. Centerline of East and West pavement is North 150' #7 Iron Fence Post S45°E 0.45' #8 15" Maple S15°W 32.52' (snag)#5 6" Ash S40°E 15.69' #3 6" Ash S45°E 14.11' (dead top)#4 6" Ash N85°E 5.42' (snag)#6	Norman L. Ochs R.L.S. #22439 October 17, 1984 Found monument

**B. DESCRIPTION OF CORNER EVIDENCE FOUND AND/OR METHOD APPLIED IN RESTORING OR REESTABLISHING CORNER:**

Found 4" square concrete monument with 1/2" rod on fence going South and on fence going East. The East edge of swamp is 125 feet ± East and the West edge of swamp is West 142 feet ±. The centerline of the East and West paved road is 150 feet ± North. The condition of the recorded witnesses are: #1 and #2 gone, #3 dead (8" Ash S28°E 15.63' Found nail in North side of tree), #4 dead (6" Ash S54°E 14.38' - center), #5 stump (16" stump S15°W 33.30' - center), #6 gone, #7 good condition, #8 bent.

**C. DESCRIPTION OF MONUMENT FOR CORNER AND ACCESSORIES ESTABLISHED TO PERPETUATE LOCATING THE POSITION OF THE CORNER:**


Accepted 4" square concrete monument with 1/2" rod as a substantial marker for the section corner and is accepted as a careful and faithful reestablishment of the position of the original corner.

16" Maple (blazed) S20°W 58.39' Set spike with tag #22439 in Northwest side of tree.  
16" Maple (blazed) N15°E 77.08' Set spike with tag #22439 in West side of tree.  
12" White Pine (blazed) N86°E 150.00' Set spike with tag #22439 in South side of tree.  
24" White Oak (blazed) S75°W 167.19' Set spike with tag #22439 in Northerly side of tree.

Signed by Norman L. Ochs Date November 8, 1999

Surveyor's Michigan License No. 22439

Form approved by Michigan State Board of Land Surveyors, October 23, 1975  
Revised May 1975  
Revised Jan., 1983

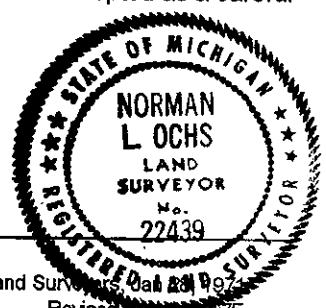

Approved by Peer Review Group on December 16, 1999  
Norman L. Ochs, County Representative.

*N. L. O.*