

SURVEY & REMONUMENTATION

MAY 28 1997 1996 Newaygo County Remonumentation Project

NEWAYGO COUNTY REGISTER OF DEEDS LINDA M. BROWN

COMMISSIONER LAND CORNER RECORDATION CERTIFICATE FILING REQUIREMENT of Act 74, Mich. P.A. 1970

'97 FEB 12 PM 4 45

Linda M. Brown

For corners in <u>Newaygo</u> (County)	Located in:	Corner Code #
1. Public Land Survey	T <u>13N</u> R <u>13W</u>	<u>K-9</u>
	T _____ R _____	_____
	T _____ R _____	_____
	T _____ R _____	_____
2. Property Controlling in Section	S _____ T _____ R _____	_____
	S _____ T _____ R _____	_____
3. Miscellaneous Property in Sec.	S _____ T _____ R _____	_____
	S _____ T _____ R _____	_____
4. Lot No. _____, Recorded Plat _____		
5. Private Claims _____		

VOL. 1 PAGE 243

Register of Deeds Stamp & File Number

	A	B	C	D	E	F	G	H	I	J	K	L	M
2	0	5	4	3	2								
3													
4	7	0	9	10	11	12							
5													
6	10	17	10	15	14	13							
7													
8	19	20	21	22	23	24							
9													
10	30	29	28	27	26	25							
11													
12	31	32	33	34	35	36							
13													

I, Norman L. Ochs, in a field survey on September 4, 1996 do hereby certify that under requirements of P. A. 74, Michigan P.A. of 1970, the corner points mentioned in lines 1 and 2 above were in conformance with regulations and rules therefore as required in the current manual of survey instructions of the United States Department of the Interior, Bureau of Land Management or by a decree of a Court of Law and/or that the corner points mentioned in lines 3, 4 and 5 above were in conformance with the rules of the Michigan Board of Land Surveyors or by a Decree of a Court of Law, established, re-established, monumented, re-monumented, recovered, found as expressed below:

Note: Not more than 4 corners, all in the same town and range, may be recorded on this certificate.

Northwest Corner, Section 25, Sherman Township, Newaygo County, Michigan

A. DESCRIPTION OF ORIGINAL MONUMENT AND ACCESSORIES AND/OR SUBSEQUENT RESTORATION:

- | | |
|---|---|
| G.L.O. John H. Mullett 1839
8" Maple S29°E 23 Links (15.18') #1
8" Maple N59°E 4 Links (2.64') #2 | Ralph A. Smith R.L.S. #3421
Field Notes Found Pipe
16" Twin White Oak N01°E 32.74' #3
14" Twin Black Oak N73°E 12.15' #4
12" Twin White Oak S66°E 32.75' #5 |
| Delos G. Anderson (County Surveyor)
Book A Page 317 November 13-14-15, 1901
Old Government corner Railroad Iron for corner | NCRC Sheet
Pipe
12" White Oak N41°W 46.7' #6
10" White Oak N46°E 49.2' #7 |
| Donald W. Schiele R.L.S. #23517
April 20, 1978 Series I Number 6787 and LCRC #488
Found 3/4" Iron Pipe
20" Twin Oak North 32.55' #3
18" Twin Oak East Northeast 11.85' #4
16" Twin Oak East Southeast 32.58' #5 | |
| Norman L. Ochs R.L.S. #22439
LCRC #864 January 17, 1989
Found 3/4" Pipe in fill on East side of road. Set a 4" diameter Harrison cast iron monument on top of 3/4" Pipe
19"-22" Twin Black Oak N73°E 13.00' #4
15" White Oak S66°E 33.36' #5
24" Forked White Oak N11°E 33.19' #8
5" White Pine N30°W 26.00' #9 | |

B. DESCRIPTION OF CORNER EVIDENCE FOUND AND/OR METHOD APPLIED IN RESTORING OR REESTABLISHING CORNER:

Found 4" diameter Harrison cast iron monument approximately at the point of intersection of road and the centerline of road is Southwest 34 feet and the condition of the recorded witnesses are: #1 and #2 gone, #3 thru #5 good condition, #6 thru #8 gone, #9 good condition.

C. DESCRIPTION OF MONUMENT FOR CORNER AND ACCESSORIES ESTABLISHED TO PERPETUATE LOCATING THE POSITION OF THE CORNER:

Accepted 4" diameter Harrison cast iron monument 20" long marked "County Surveyor" as a substantial marker for the section corner and is accepted as a careful and faithful reestablishment of the original corner.


- 16"-16" Twin White Oak N01°E 32.85' Spike in West side of tree. #3
- 18"-18" Twin Black Oak N73°E 12.42' Spike in North side of tree. #4
- 16" Twin White Oak S66°E 33.09' Spike in North side of tree. #5
- 7" White Pine N18°W 25.98' Spike in Southwest side of tree. #9

Signed by Norman L. Ochs Date September 13, 1996

Norman L. Ochs

Surveyor's Michigan License No. 22439

Form approved by Michigan State Board of Land Surveyors, Jan 28, 1973
Revised March 11, 1973
Revised Jan., 1983

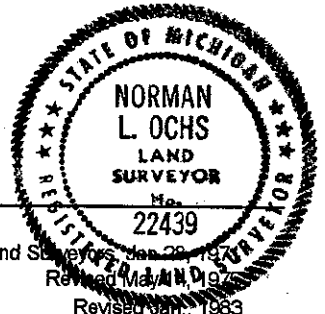

Approved by Peer Review Group On September 17, 1996
Norman L. Ochs, County Representative.

N.L.O.