

**SURVEY & REMONUMENTATION**

**MAR 1 3 2000**

**1999 Newaygo County Remonumentation Project**

NEWAYGO COUNTY  
REGISTER OF DEEDS  
LINDA M. BROWN

**SECTION**

**LAND CORNER RECORDATION CERTIFICATE  
FILING REQUIREMENT of Act 74, Mich. P.A. 1970**

'00 FEB 28 PM 1 17.

|  |                           |               |
|--|---------------------------|---------------|
| For corners in<br><u>Newaygo</u><br>(County) | Located in:               | Corner Code # |
| 1. Public Land Survey                        | T <u>13N</u> R <u>13W</u> | <u>L-11</u>   |
|  | T ___ R ___               | _____         |
|  | T ___ R ___               | _____         |
|  | T ___ R ___               | _____         |
| 2. Property Controlling<br>in Section        | S ___ T ___ R ___         | _____         |
|  | S ___ T ___ R ___         | _____         |
| 3. Miscellaneous<br>Property in Sec.         | S ___ T ___ R ___         | _____         |
|  | S ___ T ___ R ___         | _____         |
| 4. Lot No. _____, Recorded Plat _____        |                           |               |
| 5. Private Claims _____                      |                           |               |

*Linda M. Brown*

**VOL. 2                      348**

**Register of Deeds Stamp & File Number**

|    |    |    |    |    |    |    |   |   |   |   |   |   |   |
|----|----|----|----|----|----|----|---|---|---|---|---|---|---|
| 1  | A  | B  | C  | D  | E  | F  | G | H | I | J | K | L | M |
| 2  | 6  | 5  | 4  | 3  | 2  | 1  |   |   |   |   |   |   |   |
| 3  |    |    |    |    |    |    |   |   |   |   |   |   |   |
| 4  | 7  | 8  | 9  | 10 | 11 | 12 |   |   |   |   |   |   |   |
| 5  |    |    |    |    |    |    |   |   |   |   |   |   |   |
| 6  | 18 | 17 | 16 | 15 | 14 | 13 |   |   |   |   |   |   |   |
| 7  |    |    |    |    |    |    |   |   |   |   |   |   |   |
| 8  | 19 | 20 | 21 | 22 | 23 | 24 |   |   |   |   |   |   |   |
| 9  |    |    |    |    |    |    |   |   |   |   |   |   |   |
| 10 | 30 | 29 | 28 | 27 | 26 | 25 |   |   |   |   |   |   |   |
| 11 |    |    |    |    |    |    |   |   |   |   |   |   |   |
| 12 | 31 | 32 | 33 | 34 | 35 | 36 |   |   |   |   |   |   |   |
| 13 |    |    |    |    |    |    |   |   |   |   |   |   |   |

I, Norman L. Ochs, in a field survey on October 8, 1999, do hereby certify that under requirements of P. A. 74, Michigan P.A. of 1970, the corner points mentioned in lines 1 and 2 above were in conformance with regulations and rules therefore as required in the current manual of survey instructions of the United States Department of the Interior, Bureau of Land Management or by a decree of a Court of Law and/or that the corner points mentioned in lines 3, 4 and 5 above were in conformance with the rules of the Michigan Board of Land Surveyors or by a Decree of a Court of Law; established, re-established, monumented, re-monumented, recovered, found as expressed below:

**Note: Not more than 4 corners, all in the same town and range, may be recorded on this certificate.**

North One Quarter Corner, Section 36, Sherman Township, Newaygo County, Michigan.

**A. DESCRIPTION OF ORIGINAL MONUMENT AND ACCESSORIES AND/OR SUBSEQUENT RESTORATION:**

|  |  |
|--|--|
| G.L.O. John Mullett 1838<br>8" Maple S34°E 5 Links (3.30')#1<br>8" Maple N58°E 29 Links (19.14')#2                                 | Norman L. Ochs R.L.S. #22439<br>1978 Found Monument Box with 1/2" Rod<br>12" - 10" Twin Ash N41°E 88.47' #3<br>4" - 6" Twin Ash N44°W 76.14' #6<br>Northeast Corner Garage S28°W 67.90' #7 |
| Newaygo County Road Commission Sheet<br>1/2" Iron<br>12" Ash N41°E 87.65' #3<br>5" Ash N29°W 75.64' #4<br>1/2" Iron S04°W 75.0' #5 | Donald W. Schiele R.L.S. #23517<br>August 10, 1978 LCRC #489<br>Found 1/2" Iron<br>14" Ash N41°E 87.85' #3<br>6" Ash N29°W 75.45' #4<br>North Corner of Garage Southwest 67.80' #7         |
| Norman L. Ochs R.L.S. #22439<br>October 7, 1982 Found 1/2" Iron in Monument Box<br>at the top of a hill.                           |  |

OVER ↵

**B. DESCRIPTION OF CORNER EVIDENCE FOUND AND/OR METHOD APPLIED IN RESTORING OR REESTABLISHING CORNER:**

Found 1" x 24" Rod, raised with a 1/2" x 18" Rerod in Monument Box, on line ± with the centerline of the East and West bituminous road and on line ± with a stump row fence going South and the fence going North is 10 feet ± East. The condition of the recorded witnesses are: #1 and #2 gone, #3 found 12", 12" Twin Stump N41°E 88' ± to center, #4 and #5 gone, #6 and #7 good condition.

**C. DESCRIPTION OF MONUMENT FOR CORNER AND ACCESSORIES ESTABLISHED TO PERPETUATE LOCATING THE POSITION OF THE CORNER:**

Removed 1" x 24" Rod, 1/2" x 18" Rerod and monument box and set a 2 3/4" diameter Harrison cast iron monument 20" long marked "County Survey" in a new 8" diameter monument box as a substantial marker for the quarter corner and is accepted as a careful and faithful reestablishment of the original corner.

6" - 10" Twin Ash (blazed) N42°W 75.39' Found spike in West side of tree. #6  
Northwest Corner frame garage (measured to siding) S22°W 67.69' #7  
Power Pole S29°E 66.54' Set spike with tag #22439 in East side of pole.  
18" White Oak (blazed) N66°W 122.08' Set spike with tag #22439 in Northeast side of tree.


Signed by Norman L. Ochs Date October 22, 1999

Surveyor's Michigan License No. 22439

Form approved by Michigan State Board of Land Surveyors Jan 26, 1974  
Revised May 14, 1975  
Revised Jan., 1983

Approved by Peer Review Group on October 28, 1999  
Norman L. Ochs, County Representative.

*N.L.O.*

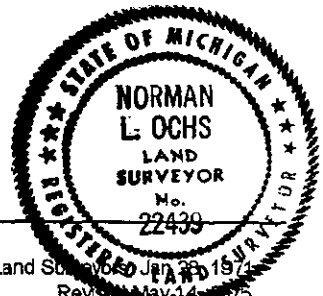

A. Description (cont.)

Norman L. Ochs R.L.S. #22439  
July 6, 1983 Drawing Number 82085AC  
Found Monument Box with 1/2" Iron  
10" - 12" Twin Ash N41°E 88.47' #3  
4" - 6" Twin Ash N44°W 76.14' #6  
Northeast Corner Garage S28°W 67.90' #7

Norman L. Ochs R.L.S. #22439  
December 12, 1984 Drawing Number 84174B  
Found 1/2" Rod  
10" - 12" Twin Ash N41°E 87.38' #3  
4" - 6" Twin Ash N44°W 76.1' #6  
Northeast Corner Garage S28°W 67.10' #7

John E. Doornbos R.L.S. #39076  
Liber 362, Page 7460 November 7, 1995  
Iron in Monument Box per Newaygo County Records

SURVEY &  
REMONUMENTATION

MAR 13 2000

SECTION