

MAY 28 1997

COMMISSION

1996 Newaygo County Remonumentation Project

LAND CORNER RECORDATION CERTIFICATE  
FILING REQUIREMENT of Act 74, Mich. P.A. 1970


NEWAYGO COUNTY  
REGISTER OF DEEDS  
LINDA M. BROWN

'97 FEB 12 PM 4 45

*Linda M. Brown*

For corners in Newaygo Located in: \_\_\_\_\_ Corner Code # \_\_\_\_\_  
(County)

- 1. Public Land Survey T 13N R 12W  
T 13N R 13W  
T \_\_\_\_\_ R \_\_\_\_\_  
T \_\_\_\_\_ R \_\_\_\_\_
- 2. Property Controlling in Section S \_\_\_\_\_ T \_\_\_\_\_ R \_\_\_\_\_  
S \_\_\_\_\_ T \_\_\_\_\_ R \_\_\_\_\_
- 3. Miscellaneous Property in Sec. S \_\_\_\_\_ T \_\_\_\_\_ R \_\_\_\_\_  
S \_\_\_\_\_ T \_\_\_\_\_ R \_\_\_\_\_
- 4. Lot No. \_\_\_\_\_, Recorded Plat \_\_\_\_\_
- 5. Private Claims \_\_\_\_\_

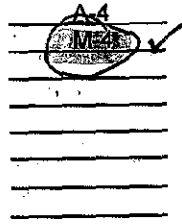

VOL. 1 PAGE 238

Register of Deeds Stamp & File Number

	A	B	C	D	E	F	G	H	I	J	K	L	M
13													

I, Norman L. Ochs, in a field survey on December 17, 1996, do hereby certify that under requirements of P. A. 74, Michigan P.A. of 1970, the corner points mentioned in lines 1 and 2 above were in conformance with regulations and rules therefore as required in the current manual of survey instructions of the United States Department of the Interior, Bureau of Land Management or by a decree of a Court of Law and/or that the corner points mentioned in lines 3, 4 and 5 above were in conformance with the rules of the Michigan Board of Land Surveyors or by a Decree of a Court of Law; established, re-established, monumented, re-monumented, recovered, found as expressed below:

Note: Not more than 4 corners, all in the same town and range, may be recorded on this certificate.

West One Quarter Corner, Section 7, Everett Township, Newaygo County, Michigan  
East One Quarter Corner, Section 12, Sherman Township, Newaygo County, Michigan

A. DESCRIPTION OF ORIGINAL MONUMENT AND ACCESSORIES AND/OR SUBSEQUENT RESTORATION:

- G.L.O. John H. Mullett 1837  
12" Beech S36°W 32 Links (21.12') #1  
10" Beech N35°W 54 Links (35.64') #2
- William M. Jacques (County Surveyor)  
Book 24 Page 11 June 29, 1908  
18" Pine Stump S69°W 38 1/4 Links (25.25') #3
- Patrick A. Salisbury R.L.S. #13594  
April 4, 1972 Set 3/4" Iron Pipe  
14"-16" Twin White Oak N25°30'E 73.20' #7  
16" White Oak N29°W 81.80' #8  
18" White Oak S20°W 27.90' #9
- NCRC Sheet  
4" Oak S40°E 63.5' #4  
Ash West 24.7' #5
- Ralph A. Smith R.L.S. #3421  
Book 68 Page 64 1950 Iron  
20" White Oak N40°W 73.3' #6  
6" Oak N20°E 72.9' #7

B. DESCRIPTION OF CORNER EVIDENCE FOUND AND/OR METHOD APPLIED IN RESTORING OR REESTABLISHING CORNER:

Found 5/8" X 18" Iron Pipe and the centerline of North and South dirt road is 5 feet East and the centerline of trail road going West is 30 feet North and the condition of the recorded witnesses are: #1 thru #6 gone, #7 thru #9 (stumps).


C. DESCRIPTION OF MONUMENT FOR CORNER AND ACCESSORIES ESTABLISHED TO PERPETUATE LOCATING THE POSITION OF THE CORNER:

Removed 5/8" X 18" Iron Pipe and set a 4" diameter Harrison cast iron monument 20" long marked "County Surveyor" as a substantial marker for the section corner and is accepted as a careful and faithful reestablishment of the original corner.

- 18" Oak Stump N26°E 73.23' Found spike in Northwest side of stump. #7
- 20" Oak Stump N28°W 82' Center. #8
- 24" Oak Stump S22°W 27.76' Found spike in East side of stump. #9
- 14" Red Pine S33°E 35.90' Set spike and tag in Southwest side of tree.
- 12" Red Pine N63°E 40.85' Set spike and tag in Northwest side of tree.
- 14" Red Pine N84°W 82.53' Set spike and tag in South side of tree.
- 8" Red Pine N50°W 85.95' Set spike and tag in Southwest side of tree.

Signed by Norman L. Ochs Date December 20, 1996  
Norman L. Ochs

Surveyor's Michigan License No. 22439 Form approved by Michigan State Board of Land Surveyors, Jan 28, 1971  
Approved by Peer Review Group On December 23, 1996 Revised May 14, 1975  
Norman L. Ochs, County Representative. Revised Jan., 1983

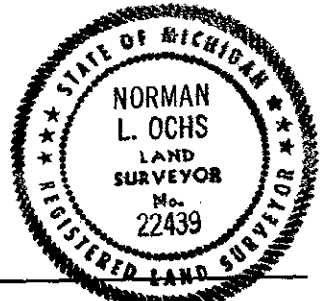

*N. L. O.*