

SURVEY & REMONUMENTATION

MAR 19 1998

1997 Newaygo County Remonumentation Project

NEWAYGO COUNTY,
REGISTER OF DEEDS
LINDA M. BROWN

SECTION

**LAND CORNER RECORDATION CERTIFICATE
FILING REQUIREMENT of Act 74, Mich. P.A. 1970**

'98 MAR 6 PM 12 35

For corners in Newaygo (County) Located in: _____ Corner Code # _____

1. Public Land Survey T 13N R 14W C-5
 T _____ R _____
 T _____ R _____
 T _____ R _____

2. Property Controlling in Section S _____ T _____ R _____
 S _____ T _____ R _____

3. Miscellaneous Property in Sec. S _____ T _____ R _____
 S _____ T _____ R _____

4. Lot No. _____, Recorded Plat _____

5. Private Claims _____

Linda M. Brown

VOL. 2

86

Register of Deeds Stamp & File Number

	A	B	C	D	E	F	G	H	I	J	K	L	M
1													
2	6	5	4	3	2	1							
3													
4	7	8	9	10	11	12							
5													
6	18	17	16	15	14	13							
7													
8	19	20	21	22	23	24							
9													
10	30	29	28	27	26	25							
11													
12	31	32	33	34	35	36							
13													

I, Norman L. Ochs, in a field survey on August 23, 1997, do hereby certify that under requirements of P. A. 74, Michigan P.A. of 1970, the corner points mentioned in lines 1 and 2 above were in conformance with regulations and rules therefore as required in the current manual of survey instructions of the United States Department of the Interior, Bureau of Land Management or by a decree of a Court of Law and/or that the corner points mentioned in lines 3, 4 and 5 above were in conformance with the rules of the Michigan Board of Land Surveyors or by a Decree of a Court of Law; established, re-established, monumented, re-monumented, recovered, found as expressed below:

Note: Not more than 4 corners, all in the same town and range, may be recorded on this certificate.

Southwest Corner, Section 8, Dayton Township, Newaygo County, Michigan.

A. DESCRIPTION OF ORIGINAL MONUMENT AND ACCESSORIES AND/OR SUBSEQUENT RESTORATION:

G.L.O. John Mullett 1838
 10" Beech N45°E 19 Links (12.54') #1
 10" Beech S07°E 11 Links (7.26') #2

Newaygo Engineering and Survey Company
 November 30, 1977 Found 1/2" Pipe
 Power Pole N24°W 69.40' #6
 28" Ash N75°W 126.76' #7
 Power Pole S75°E 199.37' #8

Newaygo County Road Commission
 3/4" Pipe
 24" Cherry N20°E 94.2' #3
 Telephone Pole S49°W 41.8' #4
 5" Elm N65°E 113.9' #5

Newaygo County Road Commission Information on
 See LCRC #1239 3/4" Pipe
 14" Cherry N27°W 70.8' #9
 Telephone Pole S49°W 41.8' #4
 5" Elm N65°E 113.9' #5

Newaygo County Road Commission Information on
 See LCRC #1239 1975 1/2" Pipe
 Power Pole N30°W 69.4' #6
 2" Maple N45°E 83.8' #10

OVER ↵

B. DESCRIPTION OF CORNER EVIDENCE FOUND AND/OR METHOD APPLIED IN RESTORING OR REESTABLISHING CORNER:

Found 1/2" X 18" Pipe over Cabin spike at surface of bituminous road. Pipe flat in North end of hole 22" below surface. The centerline of bituminous road going North and South is 1 foot West and the centerline of gravel road going East and West is 3 feet North. The condition of the recorded witnesses are: #1 thru #5 gone, #6 thru #8 good condition, #9 and #10 gone, #11 good condition, #12 gone.

C. DESCRIPTION OF MONUMENT FOR CORNER AND ACCESSORIES ESTABLISHED TO PERPETUATE LOCATING THE POSITION OF THE CORNER:

Removed 1/2" Pipe and Cabin spike and set a 4" diameter Harrison cast iron monument 20" long over Pipe flat in hole, marked "County Surveyor" as a substantial marker for the section corner and is accepted as a careful and faithful reestablishment of the original corner.

Power Pole N19°W 69.37' Found spike in Southwest side of pole. #6
 36" Ash N65°W 126.45' Set spike with tag in North side of tree and found nail #30389 in root 126.61' #7
 Power Pole S80°E 199.29' Found P.K. with tag in North side of pole. #8
 16" Maple N60°E 83.56' Found spike with tag in North side of tree. #11


Signed by Norman L. Ochs Date September 8, 1997
 Norman L. Ochs

Surveyor's Michigan License No. 22439

 Revised May 14, 1975
 Revised Jan 1, 1983

Approved by Peer Review Group on October 14, 1997
 Norman L. Ochs, County Representative.

N.L.O.

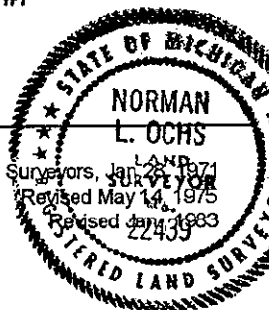

A. Description (cont.)

William Fries, Jr. R.L.S. #30389

LCRC #1239 November 19, 1994

Found big nail in 7/8" outside diameter Pipe. Turned Pipe over so 7/8" outside diameter Pipe is showing and nail is under Pipe now.

16" Maple N54°E 83.63' Nail in root. #11

Power Pole S08°W 199.23' #12

40" Ash N77°W 126.61' #7

Power Pole N31°W 69.36' #6

Stanley Kass R.L.S. #34972

February 15, 1993 Found 3/4" Pipe Job #93-0091

Power Pole N31°W 69.32' #6

28" Ash N75°W 126.66' #7

Power Pole S82°E 199.18' #12

Centerline Telephone Riser #1605 S43°W 42.62' #13