

MAR 02 1999

NEWAYGO COUNTY REGISTER OF DEEDS

1998 Newaygo County Remonumentation Project LINDA M. BROWN

SECTION

LAND CORNER RECORDATION CERTIFICATE FEB 17 PM 3 38 FILING REQUIREMENT of Act 74, Mich. P.A. 1970

For corners in Newaygo (County) Located in: Corner Code #

1. Public Land Survey T 13N R 14W H-7  
 T \_\_\_ R \_\_\_  
 T \_\_\_ R \_\_\_  
 T \_\_\_ R \_\_\_

2. Property Controlling in Section S \_\_\_ T \_\_\_ R \_\_\_  
 S \_\_\_ T \_\_\_ R \_\_\_

3. Miscellaneous Property in Sec. S \_\_\_ T \_\_\_ R \_\_\_  
 S \_\_\_ T \_\_\_ R \_\_\_

4. Lot No. \_\_\_\_\_, Recorded Plat \_\_\_\_\_

5. Private Claims \_\_\_\_\_

*Linda M. Brown*

VOL. 2 215

Register of Deeds Stamp & File Number

	A	B	C	D	E	F	G	H	I	J	K	L	M
1													
2	6	5	4	3	2	1							
3													
4	7	8	9	10	11	12							
5													
6	18	17	16	15	14	13							
7													
8	19	20	21	22	23	24							
9													
10	30	29	28	27	26	25							
11													
12	31	32	33	34	35	36							
13													

I, Norman L. Ochs, in a field survey on December 16, 1998, do hereby certify that under requirements of P. A. 74, Michigan P.A. of 1970, the corner points mentioned in lines 1 and 2 above were in conformance with regulations and rules therefore as required in the current manual of survey instructions of the United States Department of the Interior, Bureau of Land Management or by a decree of a Court of Law and/or that the corner points mentioned in lines 3, 4 and 5 above were in conformance with the rules of the Michigan Board of Land Surveyors or by a Decree of a Court of Law; established, re-established, monumented, re-monumented, recovered, found as expressed below:

Note: Not more than 4 corners, all in the same town and range, may be recorded on this certificate.

North One Quarter Corner, Section 22, Dayton Township, Newaygo County, Michigan.

A. DESCRIPTION OF ORIGINAL MONUMENT AND ACCESSORIES AND/OR SUBSEQUENT RESTORATION:

G.L.O. John Mullett 1838  
 12" Birch N48°E 23 Links (15.18')#1  
 8" Birch S43°E 22 Links (14.52')#2

County Surveyor's Witness Book  
 8" White Oak N22½°E 24 Links (15.84')#3

Delos G. Anderson (County Surveyor)  
 Book A, Page 160 July 15, 1895  
 Book A, Page 305 August 8, 1900  
 Old Corner stake in middle of crossway.

Newaygo County Road Commission Sheet  
 Pipe  
 Gate Post South 32.3' #4

William Fries, Jr. R.L.S. #30389  
 LCRC #1032 September 18, 1990  
 Found 1" X 1½" Metal object in occupied centerline of East and West road.  
 ½" Iron (no cap) N45°E 59.71' #5  
 ½" Iron (no cap) N45°E 92.63' #6  
 Nail and tag in ground S70°E 84.21' #7  
 Nail and tag in ground S70°E 112.76'

B. DESCRIPTION OF CORNER EVIDENCE FOUND AND/OR METHOD APPLIED IN RESTORING OR REESTABLISHING CORNER:

Found 1½" X 1½" Angle Iron, next to a 1" X 44" Iron Pipe on line ± with the centerline of ditch going North. The centerline of the East and West bituminous road is 2.5 feet ± South and there is no occupation going South. The condition of the recorded witnesses are: #1 thru #5 gone, #6 and #7 good condition, #8 gone.

C. DESCRIPTION OF MONUMENT FOR CORNER AND ACCESSORIES ESTABLISHED TO PERPETUATE LOCATING THE POSITION OF THE CORNER:

Removed Angle Iron and Iron Pipe and set a 2¾" diameter Harrison cast iron monument 28" long marked "County Survey" as a substantial marker for the section corner and is accepted as a careful and faithful reestablishment of the original corner.

½" Rerod 3" ± above grade N45°E 92.82' #6  
 Spike with tag "Advanced Survey and Map" in ground S70°E 84.29' #7  
 6" Sassafras N72°E 65.15' Set spike with tag #22439 in Southeast side of tree.  
 ½" X 18" Rerod with cap #22439 S49°W 56.41' (Set)  
 ½" X 18" Rerod with cap #22439 N62°W 41.55' (Set)  
 No other available witnesses.


Signed by Norman L. Ochs

Date December 18, 1998

Surveyor's Michigan License No. 22439

Form approved by Michigan State Board of Land Surveyors, Jan 28, 1971  
 Revised May 14, 1975  
 Revised Jan., 1983

Approved by Peer Review Group on December 22, 1998  
 Norman L. Ochs, County Representative.

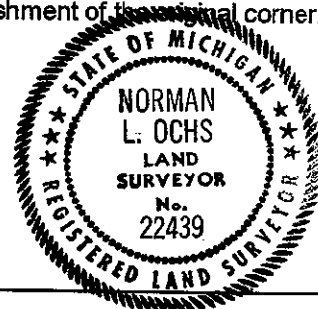

*N.L.O.*