

# SURVEY & REMONUMENTATION

1994 NEWAYGO COUNTY REMONUMENTATION PROJECT  
APR 24 1995

## COMMISSION

**LAND CORNER RECORDATION CERTIFICATE**  
Filing Requirement of Act 74, Mich. P.A. 1970

VOL **001** PAGE **114**

For corners in

Newaygo <small>(County)</small>	Located In:	Corner Code #
1. Public Land Survey	T <u>13N</u> R <u>14W</u>	K-3
	T _____ R _____	_____
	T _____ R _____	_____
	T _____ R _____	_____
2. Property Controlling in Section	S _____ T _____ R _____	_____
	S _____ T _____ R _____	_____
3. Miscellaneous Property in Sec.	S _____ T _____ R _____	_____
	S _____ T _____ R _____	_____

NEWAYGO COUNTY  
REGISTER OF DEEDS  
MARLENE TOOGOOD

'95 MAR 14 PM 3 56

*Marlene Toogood*

Register of Deeds Stamp & File Number

4. Lot No. \_\_\_\_\_, Recorded Plat \_\_\_\_\_  
5. Private Claims \_\_\_\_\_

I, Norman L. Ochs, in a field survey on May 10, 1994

do hereby certify that under requirements of P.A. 74, Michigan P.A. of 1970, the corner points mentioned in lines 1 and 2 above were in conformance with regulations and rules therefore as required in the current manual of survey instructions of the United States Department of the Interior, Bureau of Land Management or by a decree of a Court of Law and/or that the corner points mentioned in lines 3, 4 and 5 above were in conformance with the rules of the Michigan Board of Land Surveyors or by a Decree of a Court of Law; established, re-established, monumented, re-monumented, recovered, found as expressed below:

**NOTE: Not more than 4 corners, all in the same town and range, may be recorded on this certificate.**  
N.W. Corner, Section 12, Dayton Twp., Newaygo Co., MI.

A. Description of original monument and accessories and/or subsequent restoration:

G.L.O. John Mullett 1838	J.C. Brewster (Co. Surveyor) Book A Page 121	N.C.R.C. Sheet
18" Beech N35°W 23 lks. (15.18') #1	November 10, 1892 Pine Root Stake	Iron
12" Beech N78°W 20 lks. (13.20') #2	Measured 39.93 chains (2635.38 feet) from the	Tel. Pole S71°E 88.5' #3
Measured 40.04 chains (2642.64') from	NW. Cor. to the N. 1/4 Cor. of Sec. 12.	Fence Cor. S45°W 50.0' #4
the NW. Cor. to the N. 1/4 Cor. of	Measured 39.74 chains (2622.84 feet) from the	
Sec. 12.	NW. Cor. to the W. 1/4 Cor. of Sec. 12.	

OVER----->


B. Description of corner evidence found and/or method applied in restoring or reestablishing corner:

Found a 3/8" Re-rod with 1/2" Flat Iron under it. The corner is 1.7 feet South of the centerline of the East and West of blacktop road and is in centerline of the North and South gravel road and I measured 2619.85 feet from the NW. Cor. to the W. 1/4 Cor. of Sec. 12 and the condition of recorded witnesses are: #1 and #2 Gone, #3 Found pole cut, #4 Gone, #5 Good Condition, #6 Gone.

C. Description of monument for corner and accessories established to perpetuate locating the position of the corner:

Removed 3/8" Re-rod and set a 4" dia. Harrison Cast Iron Monument 20" long marked "County Surveyor" as a substantial marker for the section corner and is accepted as a careful and faithful reestablishment of the original corner.

- T. Pole Cut off S71°E 88.50' Spike in SW. side of pole #3
- P. Pole S80°W 156.14' Spike in N. side of pole #5
- P. Pole N37°W 248.90' Spike in SW. side pole
- P. Pole N57°E 282.85' Spike in SE. side of pole

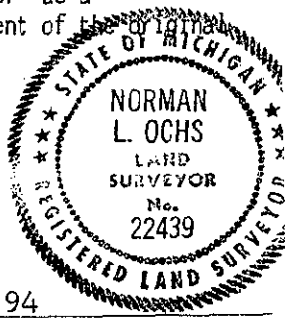

Signed by Norman L. Ochs Date November 21, 1994  
Surveyor's Michigan License No. #22439

Approved by Peer Review Group on November 22, 1994  
Norman L. Ochs, County Representative. *N.L.O.*

A: Description....(Continued)

Patrick A. Salisbury R.L.S.#13594 March 1968

Found 3/8" x 1" Iron

T. Pole S71°E 88.50' #3

T. Pole S75°W 155.80' #5

5" Pine S45°W 124.2' #6

Measured 2652.25 feet from the SW. Cor. to the W. 1/4 Cor. of Sec. 1. Measured 2637.02 feet from the SW. Cor. to the S. 1/4 Cor. of Sec. 1 and measured 2618.87 feet from the NW. Cor. to the W. 1/4 Cor. of Sec. 12.