

**SURVEY & REMONUMENTATION**

**MAR 19 1998**

**1997 Newaygo County Remonumentation Project**

NEWAYGO COUNTY  
REGISTER OF DEEDS  
LINDA M. BROWN

'98 MAR 6 PM 12 35

*Linda M. Brown*

**SECTION**

**LAND CORNER RECORDATION CERTIFICATE  
FILING REQUIREMENT of Act 74, Mich. P.A. 1970**

For corners in <u>Newaygo</u> (County)	Located in:	Corner Code #
1. Public Land Survey	T <u>13N</u> R <u>13W</u>	<u>A-2</u>
	T <u>13N</u> R <u>14W</u>	<u>M-2</u> ✓
	T _____ R _____	_____
	T _____ R _____	_____
2. Property Controlling in Section	S _____ T _____ R _____	_____
	S _____ T _____ R _____	_____
3. Miscellaneous Property in Sec.	S _____ T _____ R _____	_____
	S _____ T _____ R _____	_____

**VOL. 2**

**89**

**Register of Deeds Stamp & File Number**

	A	B	C	D	E	F	G	H	I	J	K	L	M
1													
2	6	5	4	3	2	1							
3													
4	7	8	9	10	11	12							
5													
6	18	17	16	15	14	13							
7													
8	19	20	21	22	23	24							
9													
10	30	29	28	27	26	25							
11													
12	31	32	33	34	35	36							
13													

I, Norman L. Ochs, in a field survey on October 13, 1997, do hereby certify that under requirements of P. A. 74, Michigan P.A. of 1970, the corner points mentioned in lines 1 and 2 above were in conformance with regulations and rules therefore as required in the current manual of survey instructions of the United States Department of the Interior, Bureau of Land Management or by a decree of a Court of Law and/or that the corner points mentioned in lines 3, 4 and 5 above were in conformance with the rules of the Michigan Board of Land Surveyors or by a Decree of a Court of Law; established, re-established, monumented, re-monumented, recovered, found as expressed below.

**Note: Not more than 4 corners, all in the same town and range, may be recorded on this certificate.**

West One Quarter Corner, Section 6, Sherman Township, Newaygo County, Michigan.  
East One Quarter Corner, Section 1, Dayton Township, Newaygo County, Michigan.

**A. DESCRIPTION OF ORIGINAL MONUMENT AND ACCESSORIES AND/OR SUBSEQUENT RESTORATION:**

G.L.O. Mullett and Brookfield 1838  
9" Sugar S17°W 14 Links (9.24') #1  
8" Hemlock N57°W 20 Links (13.20') #2

Newaygo County Road Commission Sheet  
Pine Stump N69°E 41.5' #5  
Pine Stump N22°W 24' #6

County Surveyor's Witness Book Page 168  
12" Elm S65½°W 51½' #3  
Badge Hedge Fence 2 rods (33') North #4

Patrick A. Salisbury R.L.S. #13594  
Consumers Power Company Section Break March 1968  
Set half way on line. Set 1" Pipe 2 feet West of the West edge of road.  
Corner Fence Post N50°W 9.25' #7  
Fence Post N50°E 47.15' #8  
Telephone Pole S15°W 108.15' #9

OVER ↵

**B. DESCRIPTION OF CORNER EVIDENCE FOUND AND/OR METHOD APPLIED IN RESTORING OR REESTABLISHING CORNER:**

Found nothing. Set 4" diameter Harrison cast iron monument 20" long marked "County Surveyor" equal distance and on line between the Northwest Corner and the Southwest Corner, per Patrick A. Salisbury and G.L.O. The centerline of the North and South paved road is 13 feet East. The centerline of drive going West is 15 feet South. The centerline of fence going West is 4.38 feet North. The condition of the recorded witnesses are: #1 thru #9 gone, #10 flat on ground, #11 and #12 good condition.

**C. DESCRIPTION OF MONUMENT FOR CORNER AND ACCESSORIES ESTABLISHED TO PERPETUATE LOCATING THE POSITION OF THE CORNER:**

Accepted 4" diameter Harrison cast iron monument 20" long marked "County Surveyor" as a substantial marker for the section corner and is accepted as a careful and faithful reestablishment of the original corner.

½" Rerod with cap # JHM 27456" N82°W 33.03' #11  
½" Rerod with cap # JHM 27456" S50°W 46.32' #12  
Power Pole N88°W 46.65' Set spike and tag in South side of pole.  
Fence Post N70°E 53.48' Set spike and tag in North side of tree.  
North end of Corrugated Metal Pipe Culvert 12" N15°W 20.02' Top centerline at end.

Signed by Norman L. Ochs Date October 14, 1997  
Norman L. Ochs

Surveyor's Michigan License No. 22439


Form approved by Michigan State Board of Land Surveyors, Jan 28, 1971

Revised May 14, 1975

Revised Jan., 1983

Approved by Peer Review Group on October 14, 1997  
Norman L. Ochs, County Representative.

*N.L.O.*

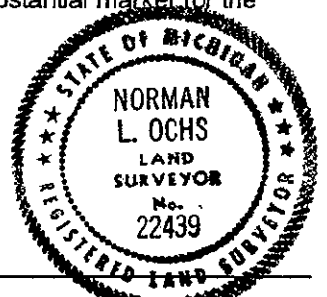

A. Description (cont.)

James H. Miller R.L.S. #27456

LCRC #1214 May 27, 1994

Corner marker and witnesses gone. Reset 1/2" Rerod half way on line between the Northeast and Southeast Corners. 1/2" Rerod as reset falls 2 feet West of West edge of road and 3.5 feet South of fence to West.

Fence Post N40°W 30.61' Nail and shiner in South face of post. #10

Steel Fence Post N50°E 51.81' #8

1/2" Rerod with cap "JHM 27456" N88°W 33.00' #11

1/2" Rerod with cap "JHM 27456" S46°W 46.45' #12