

**SURVEY &  
REMONUMENTATION**

MAR 19 1998

1997 Newaygo County Remonumentation Project

NEWAYGO COUNTY  
REGISTER OF DEEDS  
LINDA M. BROWN

**LAND CORNER RECORDATION CERTIFICATE**  
FILING REQUIREMENT of Act 74, Mich. P.A. 1970

'98 MAR 6 PM 12 36

SECTION

For corners in <u>Newaygo</u> (County)	Located in:	Corner Code #
1. Public Land Survey	T <u>14N</u> R <u>13W</u>	<u>B-3</u>
	T ___ R ___	_____
	T ___ R ___	_____
	T ___ R ___	_____
2. Property Controlling in Section	S ___ T ___ R ___	_____
	S ___ T ___ R ___	_____
3. Miscellaneous Property in Sec.	S ___ T ___ R ___	_____
	S ___ T ___ R ___	_____
4. Lot No. _____, Recorded Plat _____		
5. Private Claims _____		

*Linda M. Brown*

VOL. 2

102

Register of Deeds Stamp & File Number

	A	B	C	D	E	F	G	H	I	J	K	L	M
1													
2	6	5	4	3	2	1							
3	●												
4	7	8	9	10	11	12							
5													
6	18	17	16	15	14	13							
7													
8	19	20	21	22	23	24							
9													
10	30	29	28	27	26	25							
11													
12	31	32	33	34	35	36							
13													

I, Norman L. Ochs, in a field survey on November 5, 1997, do hereby certify that under requirements of P. A. 74, Michigan P.A. of 1970, the corner points mentioned in lines 1 and 2 above were in conformance with regulations and rules therefore as required in the current manual of survey instructions of the United States Department of the Interior, Bureau of Land Management or by a decree of a Court of Law and/or that the corner points mentioned in lines 3, 4 and 5 above were in conformance with the rules of the Michigan Board of Land Surveyors or by a Decree of a Court of Law; established, re-established, monumented, re-monumented, recovered, found as expressed below.

**Note: Not more than 4 corners, all in the same town and range, may be recorded on this certificate.**

North One Quarter Corner, Section 7, Lincoln Township, Newaygo County, Michigan.

**A. DESCRIPTION OF ORIGINAL MONUMENT AND ACCESSORIES AND/OR SUBSEQUENT RESTORATION:**

G.L.O. Milton Nye Resurvey 1856  
18" Hemlock N18°E 6 Links (3.96')#1  
20" White Pine S13°W 20 Links (13.2')#2

Delos G. Anderson (County Surveyor)  
Book A Pages 201 and 202 April 15, 1897  
Old Government Corner  
18" Pine Stub S70°W 35 Links (23.1')#3  
24" Pine Stub N45°W 39 Links (25.74')#4

OVER ↵


**B. DESCRIPTION OF CORNER EVIDENCE FOUND AND/OR METHOD APPLIED IN RESTORING OR REESTABLISHING CORNER:**

Found Robert A Griffin's 5" square concrete monument with brass cap. The centerline of the North and South gravel road is 1.5 feet West. In the centerline of extension of remains of old fence on ground going East. The condition of the recorded witnesses are: #1 thru #4 gone, #5 thru #11 good condition.

**C. DESCRIPTION OF MONUMENT FOR CORNER AND ACCESSORIES ESTABLISHED TO PERPETUATE LOCATING THE POSITION OF THE CORNER:**

Accepted Robert A. Griffin's 5" square concrete monument with brass cap as a substantial marker for the section corner and is accepted as a careful and faithful reestablishment of the original corner.

16" Red Pine N45°E 105.20' Found cabin spike with tag #13584 in Northeast side of tree. #5  
4" X 4" Treated Pine Post East 32.68' Found spike and tag #13584 in North side of post. #6  
21" Red Pine N87°E 96.98' Found spike in North side of tree. #7  
Southeast Corner House Foundation S57°W 161.57' #8  
Power Pole S70°E 24.78' Found spike and tag #13584 in North side of pole. #9  
12" Spruce S43°W 83.19' Found nail in root on Easterly side of tree. #10  
Telephone Pole West 100.87' Found spike and tag #30389 in North side of pole. #11

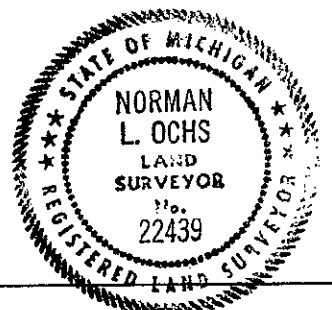

Signed by Norman L. Ochs Date November 10, 1997

Surveyor's Michigan License No. 22439

Form approved by Michigan State Board of Land Surveyors, Jan 28, 1971  
Revised May 14, 1975  
Revised Jan., 1983

Approved by Peer Review Group on November 11, 1997  
Norman L. Ochs, County Representative.

*N. L. O.*

A. Description (cont.)

Robert A. Griffin R.L.S. #13584

LCRC #65 April 31, 1970

Found 1/2" X 20" Iron rod in centerline of North and South road and in line with old fences East and West. Mr. Leo Wood says that he and others who have lived in the area for many years have always presumed that the old fences mark the section line and that the road was built on the North and South One Quarter line of Section 7. I replaced (in the exact location) the 1/2" X 20" Iron rod with a 5" Square reinforced concrete post 3 feet in length set one foot below the surface with 3" diameter brass disk.

10" Red Pine N37°E 105.23' #5

4" Square by 7' Treated Pine Post N82°E 32.72' #6

12" Red Pine N83°E 97.02' #7

Southeast Corner House Foundation (Leo Wood's House) S50°W 161.50' #8

Power Pole S74°E 24.68' #9

George W. Clark Jr. R.L.S. #6728

August 25, 1972 LCRC #54

Found concrete monument with brass cap

Power Pole S74°E 24.68' #9

4" X 4" Post N82°E 32.72' #6

10" Red Pine N83°E 97.02' #7

8" Red Pine N37°E 105.23' #5

Patrick A. Salisbury R.L.S. #13594

August 27, 1975 Drawing Number 75055B

Power Pole S74°E 24.63' #9

Pine Root N82°E 32.72' #6

10" Red Pine N37°E 105.23' #5

Newaygo Engineering and Survey Company

May 10, 1979 Drawing Number 79069B

Found square monument

10" Red Pine N37°E 105.23' #5

12" Red Pine N85°E 97.02' #7

Southeast Corner House S50°W 161.50' #8

William Fries, Jr. R.L.S. #30389

October 5, 1987 LCRC #744

Found monument

Power Pole with tag #13584 S77°E 24.65' #9

9" Spruce S33°W 83.34' #10

Telephone Pole S82°W 100.86' #11

Barn Spike N45°W 100.00' #12

Barn Spike N45°W 170.00' #13