

SURVEY & REMONUMENTATION

MAR 19 1998

1997 Newaygo County Remonumentation Project

NEWAYGO COUNTY
REGISTER OF DEEDS
LINDA M. BROWN

'98 MAR 6 PM 12 36

SECTION

LAND CORNER RECORDATION CERTIFICATE
FILING REQUIREMENT of Act 74, Mich. P.A. 1970

Linda M. Brown

For corners in
Newaygo
(County)

Located in: T 14N R 13W

Corner Code # C-5

1. Public Land Survey
T R
T R
T R
T R

2. Property Controlling
in Section
S T R
S T R

3. Miscellaneous
Property in Sec.
S T R
S T R

VOL. 2

104

4. Lot No. _____, Recorded Plat _____
5. Private Claims _____

Register of Deeds Stamp & File Number

	A	B	C	D	E	F	G	H	I	J	K	L	M
1													
2	6	5	4	3	2	1							
3													
4	7	8	9	10	11	12							
5													
6	18	17	16	15	14	13							
7													
8	19	20	21	22	23	24							
9													
10	30	29	28	27	26	25							
11													
12	31	32	33	34	35	36							
13													

I, Norman L. Ochs, in a field survey on November 5, 1997, do hereby certify that under requirements of P. A. 74, Michigan P.A. of 1970, the corner points mentioned in lines 1 and 2 above were in conformance with regulations and rules therefore as required in the current manual of survey instructions of the United States Department of the Interior, Bureau of Land Management or by a decree of a Court of Law and/or that the corner points mentioned in lines 3, 4 and 5 above were in conformance with the rules of the Michigan Board of Land Surveyors or by a Decree of a Court of Law; established, re-established, monumented, re-monumented, recovered, found as expressed below:

Note: Not more than 4 corners, all in the same town and range, may be recorded on this certificate.

Southeast Corner, Section 7, Lincoln Township, Newaygo County, Michigan.

A. DESCRIPTION OF ORIGINAL MONUMENT AND ACCESSORIES AND/OR SUBSEQUENT RESTORATION:

G.L.O. Milton Nye Resurvey 1856
16" Beech N68°W 18 Links (11.88') #1
16" Beech S12°E 10 Links (6.6') #2

Delos G. Anderson (County Surveyor)
Book A Pages 201 and 202 April 15, 1897
24" Pine Stump S87°W 7 Links (4.62') #3
24" Pine Stump N40°E 12 Links (7.92') #4

William M. Jacques (County Surveyor)
Book A Page 383 June 20, 1903
Bearing in good condition. Set new stake

Newaygo County Road Commission Sheet
1/2" Iron
18" Maple S18°W 68.1' #5
22" Maple S23°E 145.9' #6
2" Birch S56°E 154.5' #7

William M. Jacques (County Surveyor)
December 9, 1904 Book B Pages 14 and 15
Pine Root Stake - Set new stake in place of old stake

OVER ↙

B. DESCRIPTION OF CORNER EVIDENCE FOUND AND/OR METHOD APPLIED IN RESTORING OR REESTABLISHING CORNER:

Found 1/2" Rerod inside a 1 1/4" Pipe (48" long) with rock pile around. The centerline of the East and West gravel road is 3 feet South. Found old fence in trees and on ground going South, it's extension is 12 feet East. The condition of the recorded witnesses are: #1 thru #4 gone, #5 thru #9 good condition.

C. DESCRIPTION OF MONUMENT FOR CORNER AND ACCESSORIES ESTABLISHED TO PERPETUATE LOCATING THE POSITION OF THE CORNER:

Removed 1/2" Rerod and 1 1/4" Pipe and set a 4" diameter Harrison cast iron monument 20" long marked "County Surveyor" and placed rocks around base as a substantial marker for the section corner and is accepted as a careful and faithful reestablishment of the original corner.


30" Maple S23°W 69.0' Found spike and tag #22439 in East side of tree. #5
46" Maple S18°E 146.83' Found spike in East side of tree. #6
14" White Birch S55°E 154.44' Set spike and tag 3.8' above ground. #7
12" Basswood in Clump of Basswood N15°E 99.09' Found Spike in East side of tree #8
8" Elm S74°W 68.82' Found spike in South side of tree. #9

Signed by Norman L. Ochs Date November 10, 1997

Surveyor's Michigan License No. 22439

Form approved by Michigan State Board of Land Surveyors, 1971

Approved by Peer Review Group on November 11, 1997
Norman L. Ochs, County Representative.

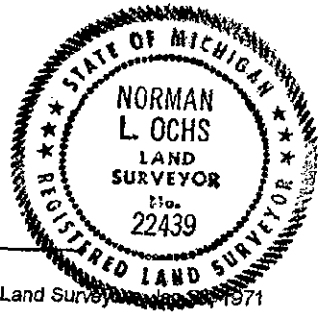

Revised May 14, 1975
Revised Jan., 1983

N. L. O.

A. Description (cont.)

George W. Clark R.L.S. #6728
LCRC #54 August 25, 1972
Found 1/2" Iron from existing witnesses
18" Maple S18°W 68.1' #5
22" Maple S23°E 145.9' #6
2" Birch S56°E 156.5' #7

Newaygo Engineering and Survey Company
1986 Found 1/2" Iron
18" Maple S18°W 68.1' #5
22" Maple S23°E 145.9' #6
2" Birch S56°E 156.5' #7
8" Clump Basswood N15°E 99.09' Spike in East side #8

Newaygo Engineering and Survey Company
January 26, 1995 Drawing Number 95013B
Found 1/2" Iron
4" Elm S70°W 68.82' #9
18" Maple S18°W 68.09' #5
36" Maple S23°E 146.85' #6
8" Clump Basswood N15°E 98.90' Spike in east side #8