

**SURVEY &
REMONUMENTATION**

MAR 19 1998

1997 Newaygo County Remonumentation Project

NEWAYGO COUNTY
REGISTER OF DEEDS
LINDA M. BROWN

'98 MAR 6 PM 12 37

SECTION

**LAND CORNER RECORDATION CERTIFICATE
FILING REQUIREMENT of Act 74, Mich. P.A. 1970**

Linda M. Brown

For corners in <u>Newaygo</u> (County)	Located in:	Corner Code #
1. Public Land Survey	T <u>15N</u> R <u>13W</u> T <u>14N</u> R <u>13W</u> T _____ R _____ T _____ R _____	<u>E-13</u> <u>E-1</u> ✓
2. Property Controlling in Section	S _____ T _____ R _____ S _____ T _____ R _____	_____
3. Miscellaneous Property in Sec.	S _____ T _____ R _____ S _____ T _____ R _____	_____
4. Lot No. _____, Recorded Plat _____		
5. Private Claims _____		

VOL. 2

129

Register of Deeds Stamp & File Number

	A	B	C	D	E	F	G	H	I	J	K	L	M
1													
2	6		5		4		3		2		1		
3													
4	7		8		9		10		11		12		
5													
6	18		17		16		15		14		13		
7													
8	19		20		21		22		23		24		
9													
10	30		29		28		27		26		25		
11													
12	31		32		33		34		35		36		
13													

I, Norman L. Ochs, in a field survey on August 7, 1997, do hereby certify that under requirements of P. A. 74, Michigan P.A. of 1970, the corner points mentioned in lines 1 and 2 above were in conformance with regulations and rules therefore as required in the current manual of survey instructions of the United States Department of the Interior, Bureau of Land Management or by a decree of a Court of Law and/or that the corner points mentioned in lines 3, 4 and 5 above were in conformance with the rules of the Michigan Board of Land Surveyors or by a Decree of a Court of Law; established, re-established, monumented, re-monumented, recovered, found as expressed below:

Note: Not more than 4 corners, all in the same town and range, may be recorded on this certificate.

Southwest Corner, Section 33, Merrill Township, Newaygo County, Michigan
Northwest Corner, Section 4, Lincoln Township, Newaygo County, Michigan

A. DESCRIPTION OF ORIGINAL MONUMENT AND ACCESSORIES AND/OR SUBSEQUENT RESTORATION:

G.L.O. Mullett and Brookfield 1838 15" Pine N23°E 45 Links (29.7')#1 16" Pine N30°W 21 Links (13.86')#2	Newaygo County Road Commission Sheet 1" Iron bar 12" Black Oak N63°W 74.5' #5 8" Black Oak S40°W 33.9' #6 10" Black Oak N24°E 65.6' #7
G.L.O. Milton Nye Resurvey 1856 11" Hemlock S72°W 41 Links (27.06')#3 16" White Oak S32½°E 54 Links (35.64')#4	

OVER ↙

B. DESCRIPTION OF CORNER EVIDENCE FOUND AND/OR METHOD APPLIED IN RESTORING OR REESTABLISHING CORNER:

Found Robert A. Griffin's 5" square concrete monument in the centerline of the East and West gravel road and the centerline of trail road going North is 52 feet East. The condition of the recorded witnesses are: #1 thru #4 gone, #5 and #6 good condition, #7 gone, #8 and #9 good condition, #10 gone, #11 good condition.

C. DESCRIPTION OF MONUMENT FOR CORNER AND ACCESSORIES ESTABLISHED TO PERPETUATE LOCATING THE POSITION OF THE CORNER:

Accepted Robert A. Griffin's concrete monument as a substantial marker for the section corner and is accepted as a careful and faithful reestablishment of the original corner.

28" Black Oak N59°W 75.30' Set spike and tag in Northeast side of tree. #5
18" Red Oak S45°W 34.32' Set spike and tag in Northwest side of tree. #6
14" White Oak N62°E 82.60' Found spike and tag in Southeast side of tree. #8
6" White Oak S13°E 77.42' Found big spike in West side of tree. #9
12" Black Oak S08°W 46.17' Found spike and tag in West side of tree. #11.


Signed by Norman L. Ochs Date October 7, 1997
Norman L. Ochs

Surveyor's Michigan License No. 22439 Form approved by Michigan State Board of Land Surveyors, Jan 28, 1971

Approved by Peer Review Group on November 11, 1997
Norman L. Ochs, County Representative.

Revised May 14, 1975
Revised Jan., 1983

N.L.O.

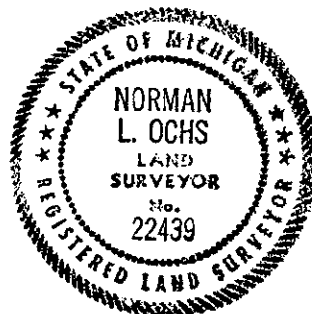

A. Description (cont.)

Robert A. Griffin R.L.S. #13584

LCRC #137 July 6, 1967

Found 28" long Iron rod in centerline of the East and West gravel road. Replaced the 1/2" X 28" Iron rod with a 5" square Concrete post 3 feet long set one foot below the surface with a brass disk.

13" Red Oak N26°E 65.50' #7

8" White Oak N60°E 82.60' #8

4" White Oak S18°E 77.69' #9

4" Square X 7' treated pine post South 33.0' #10

7" Red Oak S08°W 46.26' #11

15" Red Oak S39°W 34.30' #6

16" Red Oak N64°W 75.30' #5