

**SURVEY &
REMONUMENTATION**

APR 24 1995 1994 NEWAYGO COUNTY REMONUMENTATION PROJECT

COMMISSION

LAND CORNER RECORDATION CERTIFICATE
Filing Requirement of Act 74, Mich. P.A. 1970

VOL 001 PAGE 123

For corners in

<u>Newaygo</u> (County)	Located In:	Corner Code #
1. Public Land Survey	T <u>14N</u> R <u>13W</u>	<u>I-3</u>
	T _____ R _____	_____
	T _____ R _____	_____
	T _____ R _____	_____
2. Property Controlling in Section	S _____ T _____ R _____	_____
	S _____ T _____ R _____	_____
3. Miscellaneous Property in Sec.	S _____ T _____ R _____	_____
	S _____ T _____ R _____	_____

NEWAYGO COUNTY
REGISTER OF DEEDS
MARLENE TOOGOOD

'95 MAR 14 PM 3 57

Marlene Toogood

Register of Deeds Stamp & File Number

4. Lot No. _____, Recorded Plat _____
5. Private Claims _____

I, Norman L. Ochs, in a field survey on November 21, 1994, do hereby certify that under requirements of P.A. 74, Michigan P.A. of 1970, the corner points mentioned in lines 1 and 2 above were in conformance with regulations and rules therefore as required in the current manual of survey instructions of the United States Department of the Interior, Bureau of Land Management or by a decree of a Court of Law and/or that the corner points mentioned in lines 3, 4 and 5 above were in conformance with the rules of the Michigan Board of Land Surveyors or by a Decree of a Court of Law; established, re-established, monumented, re-monumented, recovered, found as expressed below:

NOTE: Not more than 4 corners, all in the same town and range, may be recorded on this certificate.

N.E. Corner, Section 10, Lincoln Twp., Newaygo Co., MI
A. Description of original monument and accessories and/or subsequent restoration:

G.L.O. Milton Nye 1856	September 10, 1970 Robert A. Griffin R.L.S. #13584 L.C.R.C. #67
14" Beech N06°W 44 lks. (29.04') #1	Found 1"x24" Iron pipe 9 feet West of and 7 feet South of road intersection
16" Beech S33 1/2°E 58 lks. (38.28') #2	and replaced with a 5" Sq. reinforced conc. post w/brass disc 3 feet in length and set 1 foot below the surface.
September 4, 1970 N.C.R.C.	10" W. Pine N35°E 119.42' Spike in S.E. side of tree #6 OVER----->
Pipe	6" Maple S45°E 49.48' (Center) #3
6" Maple S45°E 49.0' #3	16" Oak S35°W 54.4' (Center) #4
16" Oak S45°W 53.2' #4	7" Beech N55°W 99.57' Spike in N.E. side of tree #7
18" Oak N30°W 50.9' #5	4"x7' Pine Post North 33.14' Spike and brass tag in East side of post #8


B. Description of corner evidence found and/or method applied in restoring or reestablishing corner.

Found Robert A. Griffin's 5" Sq. Reinforced Concrete Post with brass disc. The centerline of the East and West Road is 7.5 feet South of corner and the centerline of the North and South road is 9 feet East of corner. I measured 2578.77 feet from the N. 1/4 Corner to the N.E. Corner of Section 10 and measured 2652.18 feet from the N.E. Corner to the E. 1/4 Corner of Sec. 10 and the condition of the recorded witnesses are: #1 and #2 Gone, #3 and #4 Good Condition, #5 Gone, #6 and #7 Good Condition, #8 Gone.

C. Description of monument for corner and accessories established to perpetuate locating the position of the corner:

Accepted Robert A. Griffin's Concrete Monument with brass cap (set a spike on top of monument) as a substantial marker for the section corner and is accepted as a careful and faithful reestablishment of the original corner.

12" Beech N55°W 99.61' Found spike in N.E. side of tree #7
24" W. Oak S35°W 54.4' Set spike in Westerly side of tree #4
22" W. Pine N35°E 119.43' Found spike in S.E. side of tree #6
10" Maple S45°E 49.48' Set spike in N.E. side of tree #3

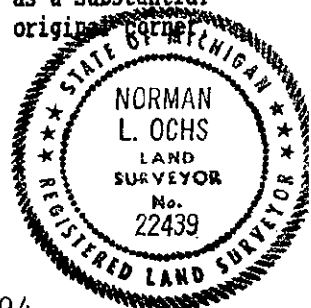

Signed by Norman L. Ochs

Date November 22, 1994

Surveyor's Michigan License No. #22439

Approved by Peer Review Group on December 1, 1994
Norman L. Ochs, County Representative. *N.L.O.*

A. Description.....(Continued)

Robert A. Griffin R.L.S. #13584 September 10, 1970

Measured 2655.59 feet from the S.W. Cor. to the W. 1/4 Cor. of Sec. 2. Measured 2535.11 feet from the S.W. Cor. to the S. 1/4 Cor. of Sec. 2. Measured 2579.40 feet from the S.E. Cor. to the S. 1/4 Cor. of Sec. 3.

Clinton E. Cole R.L.S. #17615 October 30, 1985

See survey recorded in Series R, No. 3064

10" W. Pine N35°E 119.42' #6

7" Beech N55°W 99.57' #7

6" Maple S45°E 49.48' #3

Measured 2655.57 feet from the S.W. Cor. to the W. 1/4 Cor. of Sec. 2. Measured 2535.30 feet from the S.W. Cor. to the S. 1/4 Cor. of Sec. 2. Measured 2578.97 feet from the S.E. Cor. to the S. 1/4 Cor. of Sec. 3.

Robert L. Wetherell R.L.S. #24264

Measured 2535.51 feet from the N.W. Cor. to the N. 1/4 Cor. of Sec. 11. Measured 2652.32 feet from the N.W. Cor. to the W. 1/4 Cor. of Sec. 11.

Newaygo Engineering and Survey Co. January 22, 1985

Set spike over monument from Robert A. Griffin's witnesses. Centerline of East and West Road North and centerline of Road South is West of Corner.

10" W. Pine N35°E 119.42' #6

6" Maple S45°E 49.48' #3

16" W. Oak S35°W 54.44' #4

7" Beech N55°W 99.57' #7

4"x7' Pine Post North 33.14' #8