SURVEY &
REMONUMENTATION

APR 2 4 1995

COMMISSION 1994 NEWAYGO COUNTY REMONUMENTATION PROJECT

LAND CORNER RECORDATION CERTIFICATE
Filing Requirement of Act 74, Mich. P.A. 1970

VOL 001 PAGE 124

NEWAYGO COUNTY
REGISTER OF DEEDS
MARLENE TOOGOOD

'95 MAR 14 PM 3 57

Marlene Toogood
Register of Deeds Stamp & File Number

For corners in Newaygo (County)

		Located In:	Corner Code ##
1. Public Land Survey		T 14N R 13W	I-4
		T ___ R ___	
		T ___ R ___	
		T ___ R ___	
2. Property Controlling	S ___	T ___ R ___	
in Section	S ___	T ___ R ___	
3. Miscellaneous	S ___	T ___ R ___	
Property in Sec.	S ___	T ___ R ___	

4. Lot No. _____ , Recorded Plat _____
5. Private Claims _____

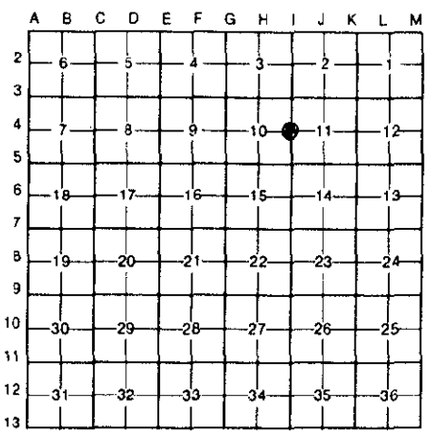

I, Norman L. Ochs, in a field survey on November 21, 19 94, do hereby certify that under requirements of P.A. 74, Michigan P.A. of 1970, the corner points mentioned in lines 1 and 2 above were in conformance with regulations and rules therefore as required in the current manual of survey instructions of the United States Department of the Interior, Bureau of Land Management or by a decree of a Court of Law and/or that the corner points mentioned in lines 3, 4 and 5 above were in conformance with the rules of the Michigan Board of Land Surveyors or by a Decree of a Court of Law; established, re-established, monumented, re-monumented, recovered, found as expressed below:

NOTE: Not more than 4 corners, all in the same town and range, may be recorded on this certificate.

E. 1/4 Corner, Section 10, Lincoln Twp., Newaygo Co., MI

A. Description of original monument and accessories and/or subsequent restoration:

G.L.O. Milton Nye 1856
16" Beech N61°E 89 lks. (58.74') #1
11" Beech S51°W 32 lks. (21.12') #2

Robert L. Wetherell R.L.S. #24624 L.C.R.C. #546 May 1982
Set 3/4" Pipe on line between N.W. Sec. Cor. and the S.W. Sec. Cor. and in fence line East and West.
8" Maple S50°E 18.39' #3
8" Maple N22°E 43.46' #4
6" Birch S84°W 54.70' #5
Measured 2652.32 feet from the N.W. Cor. to the W. 1/4 Cor. of Sec. 11 and measured 2665.29 feet from the W. 1/4 Cor. to the S.W. Cor. of Sec. 11.

B. Description of corner evidence found and/or method applied in restoring or reestablishing corner:

Found 3/4" Pipe and measured 2652.18 feet from the E. 1/4 Corner to the N.E. Corner of Sec. 10. The centerline of the North and South Road is 9 feet West of corner and the condition of the recorded witnesses are: #1 and #2 Gone, #3 thru #5 Good Condition.

C. Description of monument for corner and accessories established to perpetuate locating the position of the corner:

Removed 3/4" Pipe and set a 4" Harrison Cast Iron Monument 20" long marked County Surveyor and is a substantial marker for the section corner and is accepted as a careful and faithful reestablishment of the original corner.
5"-16" Clm. Maple N22°E 43.42' Spike in West side of clump #4
10" Maple S50°E 18.40' Spike in the West side of tree #3
12" R. Oak N50°W 47.46' Spike in West side of tree
6" Birch S84°W 54.63' Spike in South side of tree #5

STATE OF MICHIGAN
NORMAN L. OCHS
LAND SURVEYOR
No. 22439
REGISTERED LAND SURVEYOR

Signed by Norman L. Ochs Date November 22, 1994
Norman L. Ochs
Surveyor's Michigan License No. #22439

Approved by Peer Review Group on December 1, 1994
Norman L. Ochs, County Representative, N.L.O.

FORM APPROVED BY MICHIGAN STATE BOARD OF LAND SURVEYORS, JAN. 28, 1971
REVISED MAY 14, 1975
REVISED JAN., 1983