

SURVEY & REMONUMENTATION

MAR 02 1999

1998 Newaygo County Remonumentation Project

NEWAYGO COUNTY REGISTER OF DEEDS

LINDA M. BROWN

LAND CORNER RECORDATION CERTIFICATE
FILING REQUIREMENT of Act 74, Mich. P.A. 1970

FEB 17 PM 3 41

SECTION
For corners in
Newaygo
(County)

Located in:

Corner Code #

Linda M. Brown

- 1. Public Land Survey T 14N R 13W J-3
- T ___ R ___
- T ___ R ___
- T ___ R ___
- 2. Property Controlling S ___ T ___ R ___
- in Section S ___ T ___ R ___
- 3. Miscellaneous S ___ T ___ R ___
- Property in Sec. S ___ T ___ R ___
- 4. Lot No. _____, Recorded Plat _____
- 5. Private Claims _____

VOL. 2

252

Register of Deeds Stamp & File Number

	A	B	C	D	E	F	G	H	I	J	K	L	M
1													
2	6	5	4	3	2	1							
3													
4	7	8	9	10	11	12							
5													
6	18	17	16	15	14	13							
7													
8	19	20	21	22	23	24							
9													
10	30	29	28	27	26	25							
11													
12	31	32	33	34	35	36							
13													

I, Norman L. Ochs, in a field survey on November 30, 1998, do hereby certify that under requirements of P. A. 74, Michigan P.A. of 1970, the corner points mentioned in lines 1 and 2 above were in conformance with regulations and rules therefore as required in the current manual of survey instructions of the United States Department of the Interior, Bureau of Land Management or by a decree of a Court of Law and/or that the corner points mentioned in lines 3, 4 and 5 above were in conformance with the rules of the Michigan Board of Land Surveyors or by a Decree of a Court of Law, established, re-established, monumented, re-monumented, recovered, found as expressed below:

Note: Not more than 4 corners, all in the same town and range, may be recorded on this certificate.

South One Quarter Corner, Section 2, Lincoln Township, Newaygo County, Michigan.

A. DESCRIPTION OF ORIGINAL MONUMENT AND ACCESSORIES AND/OR SUBSEQUENT RESTORATION:

G.L.O. Milton Nye 1856 Resurvey
14" Hemlock N53°E 15 Links (9.9') #1
26" Hemlock S22°W 58 Links (38.28') #2

Newaygo County Road Commission Sheet
18" Maple S63°W 51.8' #3
Power Pole S35°W 50.34' #5
Power Pole N23°E 92.0' #6

Ralph A. Smith R.L.S. #3421
1950's Book 46A, Page 6 Narrow Gage Rail
15" Maple S60°W 52.1' #3
5" White Oak S45°E 39.7' #4

Robert A. Griffin R.L.S. #13584
LCRC #575 July 12, 1983 Found Railroad Rail 14" long raised with (2) 3/4" X 24" Iron Rods side by side. Set a 5" X 36" Concrete Monument with brass cap.
10" Red Pine S29°W 60.14' #7
Power Pole N24°E 92.30' #6
Power Pole S36°W 50.61' #5
10" White Pine S22°E 145.31' #8
Southwest Corner, Section 2, N87°53'51"W 2535.11' #9
Southeast Corner, Section 2, S87°53'11"E 2550.38' #10

Clinton E. Cole R.L.S. #17615
October 30, 1985 Recorded in Series R, Number 3064
10" White Pine S22°E 145.31' #8
Power Pole N24°E 92.30' #6
10" Red Pine S28°W 60.21' #7

B. DESCRIPTION OF CORNER EVIDENCE FOUND AND/OR METHOD APPLIED IN RESTORING OR REESTABLISHING CORNER:

Found Large Spike (presumably to raise 5" X 5" concrete monument). The centerline of the East and West bituminous road is 2 feet ± North and the centerline of the bituminous road going South is 3 feet ± East and the centerline of the gravel road going North is 3 feet ± West. The condition of the recorded witnesses are: #1 thru #5 gone, #6 thru #8 good condition, #9 and #10 did not verify.

C. DESCRIPTION OF MONUMENT FOR CORNER AND ACCESSORIES ESTABLISHED TO PERPETUATE LOCATING THE POSITION OF THE CORNER:

Accepted Large Spike over Concrete Monument as a substantial marker for the section corner and is accepted as a careful and faithful reestablishment of the original corner.

- Power Pole N27°E 92.48' Set spike with tag #22439 in East side of pole. #6
- 16" Red Pine S30°W 60.10' Found spike with tag in Southeasterly side of tree. #7
- 18" White Pine (blazed) S20°E 145.45' Set spike with tag #22439 in Westerly side of tree. #8
- 30" Maple S65°W 52.93' Set spike with tag #22439 in Northwesterly side of tree.


Signed by Norman L. Ochs
Norman L. Ochs

Date December 4, 1998

Surveyor's Michigan License No. 22439

Form approved by Michigan State Board of Land Surveyors, L.R.S. #137
Revised May 1, 1975
Revised Jan., 1983

Approved by Peer Review Group on December 8, 1998
Norman L. Ochs, County Representative.

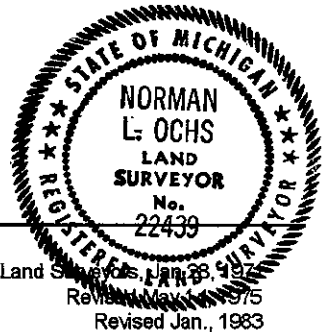

N.L.O.