

**SURVEY & REMONUMENTATION**

MAR, 02 1999

**1998 Newaygo County Remonumentation Project**

NEWAYGO COUNTY REGISTER OF DEEDS  
LINDA M. BROWN

**LAND CORNER RECORDATION CERTIFICATE  
FILING REQUIREMENT of Act 74, Mich. P.A. 1970**

'99 FEB 17 PM 3 41

**SECTION**

For corners in Newaygo (County) Located in: \_\_\_\_\_ Corner Code # \_\_\_\_\_

1. Public Land Survey T 14N R 13W J-5  
 T \_\_\_\_\_ R \_\_\_\_\_  
 T \_\_\_\_\_ R \_\_\_\_\_  
 T \_\_\_\_\_ R \_\_\_\_\_

2. Property Controlling in Section S \_\_\_\_\_ T \_\_\_\_\_ R \_\_\_\_\_  
 S \_\_\_\_\_ T \_\_\_\_\_ R \_\_\_\_\_

3. Miscellaneous Property in Sec. S \_\_\_\_\_ T \_\_\_\_\_ R \_\_\_\_\_  
 S \_\_\_\_\_ T \_\_\_\_\_ R \_\_\_\_\_

*Linda M. Brown*

VOL. 2

253

**Register of Deeds Stamp & File Number**

	A	B	C	D	E	F	G	H	I	J	K	L	M
1													
2	6	5	4	3	2	1							
3													
4	7	8	9	10	11	12							
5													
6	18	17	16	15	14	13							
7													
8	19	20	21	22	23	24							
9													
10	30	29	28	27	26	25							
11													
12	31	32	33	34	35	36							
13													

I, Norman L. Ochs, in a field survey on December 16, 1998, do hereby certify that under requirements of P. A. 74, Michigan P.A. of 1970, the corner points mentioned in lines 1 and 2 above were in conformance with regulations and rules therefore as required in the current manual of survey instructions of the United States Department of the Interior, Bureau of Land Management or by a decree of a Court of Law and/or that the corner points mentioned in lines 3, 4 and 5 above were in conformance with the rules of the Michigan Board of Land Surveyors or by a Decree of a Court of Law; established, re-established, monumented, re-monumented, recovered, found as expressed below:

**Note: Not more than 4 corners, all in the same town and range, may be recorded on this certificate.**

North One Quarter Corner, Section 14, Lincoln Township, Newaygo County, Michigan.

**A. DESCRIPTION OF ORIGINAL MONUMENT AND ACCESSORIES AND/OR SUBSEQUENT RESTORATION:**

G.L.O. Mullett and Brookfield 1838  
14" Black Oak N55°E 13 Links (8.58') #1  
12" Black Oak S55°W 9 Links (5.94') #2

Lyle S. Shepherd R.L.S. #503  
Witness Book Number 1, Page 39 Gas Pipe  
24" Pine Stump S46¾°E 34' #3

Norman L. Ochs R.L.S. #22439  
Drawing Number 72077 December 18, 1975  
Found ½" Rod  
7" Poplar S60°E 62.9' #4  
Steel Fence Post S82°E 50.0' #5

Newaygo County Road Commission Sheet  
¾" Iron  
7" Poplar S60°E 62.9' #4  
Steel Fence Post S82°E 50.0' #5  
6" Willow S83°W 61.7' #6

Robert L. Wetherell R.L.S. #24624  
June 3, 1982 File Number 3829-82  
6" Elm S38°E 61.15' #7  
10" Poplar S80°E 41.89' #8  
10" Elm S24°W 63.71' #9

OVER 6

**B. DESCRIPTION OF CORNER EVIDENCE FOUND AND/OR METHOD APPLIED IN RESTORING OR REESTABLISHING CORNER:**

Found ½" Rerod and cap #22439 in monument box in centerline of the North and South bituminous road. There is a weak woods line going East. The condition of the recorded witnesses are: #1 thru #4 gone, #5 good condition, #6 gone, #7 good condition, #8 gone, #9 and #10 good condition.

**C. DESCRIPTION OF MONUMENT FOR CORNER AND ACCESSORIES ESTABLISHED TO PERPETUATE LOCATING THE POSITION OF THE CORNER:**

Removed ½" Rerod and cap and set a 4" diameter Harrison cast iron monument 14" long, marked "County Surveyor" in a new 8" diameter monument box as a substantial marker for the section corner and is accepted as a careful and faithful reestablishment of the original corner.

Steel Fence Post S78°E 50.1' to face. #5  
14" Elm (blazed) S30°E 61.2' Set spike with tag #22439 in Northeast side of tree. #7  
14" Elm (blazed) S29°W 63.75' Found spike in Southeast side of tree. #9  
½" Rod and cap #22439 East 33.0' #10  
8" Elm (blazed) S42°E 46.2' Set spike with tag #22439 in Northeast side of tree.


Signed by Norman L. Ochs Date December 18, 1998

Surveyor's Michigan License No. 22439

Form approved by Michigan State Board of Land Surveyors, Jan 28, 1971

Approved by Peer Review Group on December 22, 1998  
Norman L. Ochs, County Representative.

*N.L.O.*

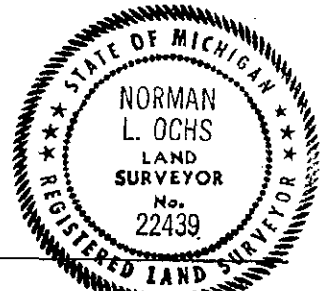

Revised May 14, 1975  
Revised Jan., 1983

A. Description (cont.)

Robert L. Wetherell R.L.S. #24624  
Recorded in Liber 352, Page 4042 June 26, 1991  
8" Elm S38°E 61.15' #7  
10" Elm S24°W 63.71' #9  
Iron Rod East 33.00' #10

Norman L. Ochs R.L.S. #22439  
September 16, 1998 Found 1/2" X 7" Rerod over a 3/4" X 8" Iron Pipe over a 1/2" X 18" Rerod. Removed and replaced with 1/2" X 18" Rerod with cap #22439 in a new 8" diameter monument box.

SURVEY &  
REMONUMENTATION

MAR 02 1999

SECTION