

MAR 18 2000

SECTION

1999 Newaygo County Remonumentation Project

LAND CORNER RECORDATION CERTIFICATE
FILING REQUIREMENT of Act 74, Mich. P.A. 1970

NEWAYGO COUNTY REGISTER OF DEEDS

LINDA M. BROWN

FEB 28 PM 1 17

Linda M. Brown

For corners in <u>Newaygo</u> (County)	Located in:	Corner Code #
1. Public Land Survey	T <u>14N</u> R <u>12W</u>	M-9
	T <u>14N</u> R <u>11W</u>	A-9 ✓
	T ___ R ___	_____
	T ___ R ___	_____
2. Property Controlling in Section	S ___ T ___ R ___	_____
	S ___ T ___ R ___	_____
3. Miscellaneous Property in Sec.	S ___ T ___ R ___	_____
	S ___ T ___ R ___	_____
4. Lot No. _____, Recorded Plat _____		
5. Private Claims _____		

VOL. 2

353

Register of Deeds Stamp & File Number

	A	B	C	D	E	F	G	H	I	J	K	L	M
1													
2	6	5	4	3	2	1							
3													
4	7	8	9	10	11	12							
5													
6	18	17	16	15	14	13							
7													
8	19	20	21	22	23	24							
9													
10	30	29	28	27	26	25							
11													
12	31	32	33	34	35	36							
13													

I, Norman L. Ochs, in a field survey on July 1, 1999, do hereby certify that under requirements of P. A. 74, Michigan P.A. of 1970, the corner points mentioned in lines 1 and 2 above were in conformance with regulations and rules therefore as required in the current manual of survey instructions of the United States Department of the Interior, Bureau of Land Management or by a decree of a Court of Law and/or that the corner points mentioned in lines 3, 4 and 5 above were in conformance with the rules of the Michigan Board of Land Surveyors or by a Decree of a Court of Law; established, re-established, monumented, re-monumented, recovered, found as expressed below:

Note: Not more than 4 corners, all in the same town and range, may be recorded on this certificate.

Southeast Corner, Section 24, Wilcox Township, Newaygo County, Michigan.
Southwest Corner, Section 19, Goodwell Township, Newaygo County, Michigan.

A. DESCRIPTION OF ORIGINAL MONUMENT AND ACCESSORIES AND/OR SUBSEQUENT RESTORATION:

G.L.O. John Hodgson 1837 (Wilcox Township)
8" Beech S25°W 25 Links (16.5') #1
16" Maple N76°W 16 Links (10.56') #2

Delos G. Anderson (County Surveyor)
Book A, Pages 221 and 222 1898 ±
22" Pine Stump S20°E 59 Links (38.94') #3
22" Pine Stump N75°E 23 Links (15.18') #4

Norman L. Ochs, R.L.S. #22439
May 31, 1983 Found 1/2" Iron, old wood stake and glass. Raised with a 1" Pipe
Northwest Leg Tower S45°E 52.50' #6
Northeast Corner House S45°W 92.65' #7
16" - 14" Twin Birch N35°E 17.63' #8

Lyle S. Shepherd R.L.S. #503
Book 36, Page 90 September 6, 1916 Gas Pipe
Witness Book Number 1, Pages 4 and 16
24" Pine Stump S14 1/2°E 38.6' #3
8" Black Oak N64 3/4°E 61' #5

OVER ↵

B. DESCRIPTION OF CORNER EVIDENCE FOUND AND/OR METHOD APPLIED IN RESTORING OR REESTABLISHING CORNER:

Found 1" x 2' Pipe above a 1/2" Rod and 2.5 feet below grade found broken glass and crockery. Corner is in the centerline of the East and West gravel road and is 1 foot West of the centerline of the North and South gravel road. The condition of the recorded witnesses are: #1 thru #5 gone, #6 and #7 good condition, #8 gone, #9 thru #11 good condition.

C. DESCRIPTION OF MONUMENT FOR CORNER AND ACCESSORIES ESTABLISHED TO PERPETUATE LOCATING THE POSITION OF THE CORNER:

Removed Pipe and Rod and set a 4" diameter Harrison cast iron monument 18" long marked "County Surveyor" as a substantial marker for the section corner and is accepted as a careful and faithful reestablishment of the original corner.

Northwest Leg of Tower S50°E 52.07' at the base. #6
Northeast Corner of House S50°W 92.64' #7
Northeast Leg of Tower N61°E 64.24' at the base. #9
30" White Oak S67°W 78.04' Set spike with tag #22439 in North side of tree. #10
Power Pole N61°W 58.81' Found P.K. nail with tag #30389 in Southwest side of pole. #11

Signed by Norman L. Ochs
Norman L. Ochs

Date August 16, 1999


Surveyor's Michigan License No. 22439

Form approved by Michigan State Board of Land Surveyors, Jan 28, 1971

Approved by Peer Review Group on October 28, 1999
Norman L. Ochs, County Representative.

Revised May 14, 1975
Revised Jan., 1983

N.L.O.

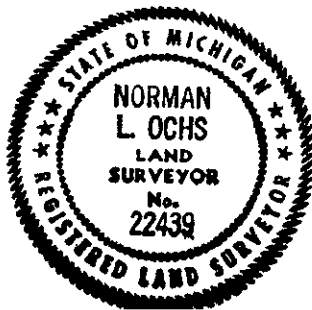

A. Description (cont.)

William Fries, Jr. R.L.S. #30389

LCRC #910 April 20, 1989 Found 1½" outside diameter Pipe in the centerline of the North-South and East-West roads.

Northeast Tower Leg S56°E 64.28' #9

Northeast Corner House #1595 S52°W 92.61' #7

24" Oak (nail in root) S69°W 78.84' #10

Power Pole N58°W 58.82' #11

SURVEY &
REMONUMENTATION

MAR 13 2000

SECTION