

**SURVEY &  
REMONUMENTATION**

APR 24 1995 1994 NEWAYGO COUNTY REMONUMENTATION PROJECT

**COMMISSION**

**LAND CORNER RECORDATION CERTIFICATE**  
Filing Requirement of Act 74, Mich. P.A. 1970

VOL 001 PAGE 118

For corners in

<u>Newaygo</u> (County)	Located In:	Corner Code #
1. Public Land Survey	T <u>14N</u> R <u>11W</u>	<u>B-7</u>
	T _____ R _____	_____
	T _____ R _____	_____
	T _____ R _____	_____
2. Property Controlling in Section	S _____ T _____ R _____	_____
	S _____ T _____ R _____	_____
3. Miscellaneous Property in Sec.	S _____ T _____ R _____	_____
	S _____ T _____ R _____	_____

NEWAYGO COUNTY  
REGISTER OF DEEDS  
MARLENE TOOGOOD

'95 MAR 14 PM 3 5

*Marlene Toogo*

Register of Deeds Stamp & File Number

4. Lot No. \_\_\_\_\_, Recorded Plat \_\_\_\_\_  
5. Private Claims \_\_\_\_\_

I, Norman L. Ochs, in a field survey on October 15, 1994, do hereby certify that under requirements of P.A. 74, Michigan P.A. of 1970, the corner points mentioned in lines 1 and 2 above were in conformance with regulations and rules therefore as required in the current manual of survey instructions of the United States Department of the Interior, Bureau of Land Management or by a decree of a Court of Law and/or that the corner points mentioned in lines 3, 4 and 5 above were in conformance with the rules of the Michigan Board of Land Surveyors or by a Decree of a Court of Law; established, re-established, monumented, re-monumented, recovered, found as expressed below:

	A	B	C	D	E	F	G	H	I	J	K	L
2	6	5	4	3	2	1						
3												
4	7	8	9	10	11	12						
5												
6	18	17	16	15	14	13						
7												
8	19	20	21	22	23	24						
9												
10	30	29	28	27	26	25						
11												
12	31	32	33	34	35	36						

**NOTE: Not more than 4 corners, all in the same town and range, may be recorded on this certificate.**

N-1/4 Corner, Section 19, Goodwell Twp., Newaygo County MI 13

A. Description of original monument and accessories and/or subsequent restoration:

GLO John Hodgson 1837 Wm. Jacques Co. Surveyor  
10" Beech N73°E 16 lks (10.56') #1 May 11, 1914 Book 2, Pg. 23  
6" Beech S36°E 19 lks (12.54') #2 Measured 5256.90 ft. from the S-1/4 cor. to the N-1/4 cor. of Sec. 18

-OVER-

Delos G. Anderson (Co. Surveyor)  
Book A Pg's 221 & 222  
Iron Rod for stake.

Measured 40.00 chains (2640 ft.) from the N-1/4 Cor. to the NW cor. of Sec. 19. NCRC Iron Fe Corner S14°W 31.2' #4  
Measured 40.00 chains (2640 ft) from the N-1/4 8" Cherry N67°E 76.0' #3


B. Description of corner evidence found and/or method applied in restoring or reestablishing corner: to the NE cor. of Section 19.

10/15/94 Found 1-1/4" iron pipe, top smashed on old fence line North & South with old glass and rock around pipe. Found bottom of No. 4 fence corner broke off. Distance was 31.2 ft.

Condition of old witnesses 1 thru 3 are gone. No. 5, 6 & 7 are good.

C. Description of monument for corner and accessories established to perpetuate locating the position of the corner: Removed 1-1/4" pipe and set a 4" dia. Harrison cast iron mon 20" long and is accepted as a careful and faithful reestablishment of the original corner.

16" Red Pine North 28.31' Spk on E side w/fences North and West.  
15" Red Pine N63°E 61.22' Spk. on SE side.  
4" Red Pine S70°E 91.46' Spk. on SWly side.  
P.Pole S77°W 193.36' Spk on S. side.

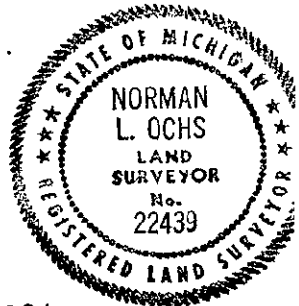

Signed by Norman L. Ochs  
Surveyor's Michigan License No. 22439

Date October 19, 1994

Approved by Peer Review Group on October 19 1994.

FORM APPROVED BY MICHIGAN STATE BOARD OF LAND SURVEYORS, JAN. 28, 1  
REVISED MAY 14, 1  
REVISED JAN., 1

Norman L. Ochs, County Representative *NLO*

A. cont.

Wm. Fries, Jr. RLS #30389

April 20, 1989 (CRC #910)

Fnd. large iron object roughly

"L" shaped in the occupied CL of an

E-W road in a N-S Fence

12" Pine AZ 62° 61.14' #5

Set nails w/plastic washer AZ 180° 55.00° #6

Set nails w/plastic washer AZ 180° 95.00' #7