

COMMISSION

LAND CORNER RECORDATION CERTIFICATE

Filing Requirement of Act 74, Mich. P.A. 1970

'94 JAN 21 PM 3 27

For corners in

NEWAYGO (County)

Located In:

Corner Code #

- 1. Public Land Survey T 14N R 11W C-12
2. Property Controlling in Section S T R
3. Miscellaneous Property in Sec. S T R

Marlene Toogood

VOL 001 PAGE 46

Register of Deeds Stamp & File Number

- 4. Lot No. Recorded Plat
5. Private Claims

Grid table with columns A-M and rows 2-12. Cell 31 contains a black dot.

I, Norman L. Ochs, in a field survey on December 22, 1993

do hereby certify that under requirements of P.A. 74, Michigan P.A. of 1970, the corner points mentioned in lines 1 and 2 above were in conformance with regulations and rules therefore as required in the current manual of survey instructions of the United States Department of the Interior, Bureau of Land Management or by a decree of a Court of Law and/or that the corner points mentioned in lines 3, 4 and 5 above were in conformance with the rules of the Michigan Board of Land Surveyors or by a Decree of a Court of Law; established, re-established, monumented, re-monumented, recovered, found as expressed below:

NOTE: Not more than 4 corners, all in the same town and range, may be recorded on this certificate.

E. 1/4 Corner, Section 31, Goodwell Twp., Newaygo Co., MI

A. Description of original monument and accessories and/or subsequent restoration:

- G.L.O. John Mullet 1837 Patrick R. Leemon 1985
18" Pine N47 W 7 lks. (4.62') #1 R.L.S. #31595 L.C.R.C. #766
6" Beech S01 E 27 lks. (17.92') #2 Found 1" Pipe
16" Maple N65 E 48.50' #3
30" B. Oak S62 E 70.20' #4
40" B. Oak N50 W 85.42' #5
Fence Corner Post West 32.95' #6
8" B. Oak S66 W 93.33' #7

B. Description of corner evidence found and/or method applied in restoring or reestablishing corner:

In 1974 Patrick A. Salisbury broke section 31. Salisbury measured S00 02' 56" E 2647.82 feet from the E. 1/4 Corner to the SE. Corner and measured N00 21' 20" E 2637.372 feet from the E. 1/4 Corner to the NE. Corner. Salisbury set 1" Pipe. In 1985 Patrick R. Leemon found 1" Pipe. Leemon broke Section 32, Goodwell Twp.. He measured S00 06' 53" E 2647.83 feet from the W. 1/4 Corner to the SW. Corner and measured N00 17' 09" E 2637.07 feet from the W. 1/4 Corner to the NW. Corner. Leemon found same witnesses as Patrick Salisbury. In 1993, I, Norman L. Ochs, found 1" Pipe and replaced with a 4" Harrison Cast Iron Monument.


Condition of recorded witnesses is: #1 Gone #2 Gone #3 Good Condition #4 Good Condition #5 Gone #6 Down on Ground #7 Gone

NOTE: Patrick Salisbury R.L.S. # 13594 in 1972 originally found a rotted wood stake in the centerline of the North and South Road and on a fence line to the West. He set the 1" Pipe in this rotted wood stake position for the 1/4 Corner.

C. Description of monument for corner and accessories established to perpetuate locating the position of the corner:

Accepted 4" Harrison Cast Iron Monument as a substantial marker for the 1/4 Corner and is accepted as a careful and faithful reestablishment of the original corner.

- 40" B. Oak S53 E 70.20' found spike in tree #4
36" Maple N70 E 48.75' Spike in South side of tree #3
40" B. Oak N38 W 139.45' Spike in South side of tree
P. Pole S17 W 143.76' Spike in NW. side of Pole

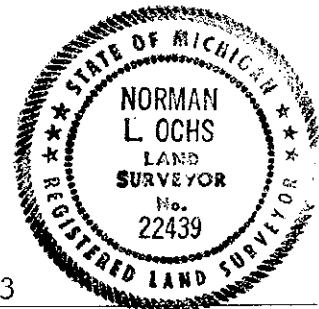

Signed by Norman L. Ochs

Date December 22, 1993

Surveyor's Michigan License No. 22439

Approved by Peer Group on December 29, 1993

Norman L. Ochs, County Representative