

1993 1993 NEWAYGO COUNTY REMONUMENTATION PROJECT

COMMISSION

LAND CORNER RECORDATION CERTIFICATE
Filing Requirement of Act 74, Mich. P.A. 1970

94 JAN 21 PM 3 27

Marlene Toogood

For corners in

<u>Newaygo</u> (County)	Located In:	Corner Code #
1. Public Land Survey	T <u>14N</u> R <u>12W</u>	<u>A-2</u>
	T _____ R _____	_____
	T _____ R _____	_____
	T _____ R _____	_____
2. Property Controlling in Section	S _____ T _____ R _____	_____
	S _____ T _____ R _____	_____
3. Miscellaneous Property in Sec.	S _____ T _____ R _____	_____
	S _____ T _____ R _____	_____

VOL 001 PAGE 42

Register of Deeds Stamp & File Number

- 4. Lot No. _____, Recorded Plat _____
- 5. Private Claims _____

	A	B	C	D	E	F	G	H	I	J	K	L	M
2	6	5	4	3	2	1							
3													
4	7	8	9	10	11	12							
5													
6	18	17	16	15	14	13							
7													
8	19	20	21	22	23	24							
9													
10	30	29	28	27	26	25							
11													
12	31	32	33	34	35	36							
13													

I, Norman L. Ochs, in a field survey on December 15, 19 93
do hereby certify that under requirements of P.A. 74, Michigan P.A. of 1970, the corner points mentioned in lines 1 and 2 above were in conformance with regulations and rules therefore as required in the current manual of survey instructions of the United States Department of the Interior, Bureau of Land Management or by a decree of a Court of Law and/or that the corner points mentioned in lines 3, 4 and 5 above were in conformance with the rules of the Michigan Board of Land Surveyors or by a Decree of a Court of Law; established, re-established, monumented, re-monumented, recovered, found as expressed below:

NOTE: Not more than 4 corners, all in the same town and range, may be recorded on this certificate.

W. 1/4 Corner, Section 6, Wilcox Twp., Newaygo Co., Mich.

A. Description of original monument and accessories and/or subsequent restoration:

G.L.O. John Hodgson 1837
Set Post
12" Beech S81°W 231ks. (15.18') #1
7" Beech N56°W 22 lks (14.52') #2

Clinton E. Cole R.L.S. #17615
November 1974
Set 3/4" pipe
8" S. Pine N36°W 29.70' #3
18" W. Oak S76°E 39.86' #4
14" B. Oak S22°W 12.03' #5
Old U.S.F.S. Location Post w/ tag #6
L.C.R.C. #349


B. Description of corner evidence found and/or method applied in restoring or reestablishing corner:

In 1974 Clinton E. Cole did a partial section break. He found old U.S.F.S. location post with tag. He set a 3/4" pipe. He measured N00°59'42"E 2674.01' from the W. 1/4 Cor. to the NW. Cor. and measured N88°59'13"E 5302.88' from the W. 1/4 Cor. to the E. 1/4 Cor. In 1993, I, Norman L. Ochs found a 3/4" iron pipe and the old U.S.F.S. Pine post with metal tag. I replaced iron pipe with a 4" Harrison Cast Iron Monument 4 inches above ground.
Condition of recorded witnesses is: #1 and #2 Gone #3 thru #6 Good Condition

C. Description of monument for corner and accessories established to perpetuate locating the position of the corner:

Accepted 4" Harrison Cast Iron Monument as a substantial marker for the 1/4 Corner and is accepted as a careful and faithful reestablishment of the original corner.

- 11" R. Pine N36°W 29.70' Spike in NE. side of tree #3
- 20" W. Oak S76°E 39.86' spike in NE. side of tree #4
- 16" B. Oak S22°W 12.03' Spike in SE. side of tree #5
- 9" B. Oak N68°E 46.82' Spike in SE. side of tree

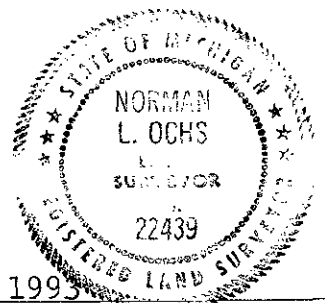

Signed by Norman L. Ochs
Norman L. Ochs R.L.S. #22439

Date December 27, 1993

Approved by Peer Group December 27, 1993

Norman L. Ochs, County Representative