

SURVEY & REMONUMENTATION

MAR 19 1998

1997 Newaygo County Remonumentation Project

NEWAYGO COUNTY
REGISTER OF DEEDS
LINDA M. BROWN

SECTION

**LAND CORNER RECORDATION CERTIFICATE
FILING REQUIREMENT of Act 74, Mich. P.A. 1970**

'98 MAR 6 PM 12 36

Linda M. Brown

For corners in <u>Newaygo</u> (County)	Located in:	Corner Code #
1. Public Land Survey	T <u>14N</u> R <u>12W</u>	<u>D-1</u>
	T _____ R _____	_____
	T _____ R _____	_____
	T _____ R _____	_____
2. Property Controlling in Section	S _____ T _____ R _____	_____
	S _____ T _____ R _____	_____
3. Miscellaneous Property in Sec.	S _____ T _____ R _____	_____
	S _____ T _____ R _____	_____
4. Lot No. _____, Recorded Plat _____		
5. Private Claims _____		

VOL. 2

110

Register of Deeds Stamp & File Number

	A	B	C	D	E	F	G	H	I	J	K	L	M
1													
2	6		5		4		3		2		1		
3													
4	7		8		9		10		11		12		
5													
6	18		17		16		15		14		13		
7													
8	19		20		21		22		23		24		
9													
10	30		29		28		27		26		25		
11													
12	31		32		33		34		35		36		
13													

I, Norman L. Ochs, in a field survey on October 9, 1997, do hereby certify that under requirements of P. A. 74, Michigan P.A. of 1970, the corner points mentioned in lines 1 and 2 above were in conformance with regulations and rules therefore as required in the current manual of survey instructions of the United States Department of the Interior, Bureau of Land Management or by a decree of a Court of Law and/or that the corner points mentioned in lines 3, 4 and 5 above were in conformance with the rules of the Michigan Board of Land Surveyors or by a Decree of a Court of Law; established, re-established, monumented, re-monumented, recovered, found as expressed below:

Note: Not more than 4 corners, all in the same town and range, may be recorded on this certificate.

North One Quarter Corner, Section 5, Wilcox Township, Newaygo County, Michigan.

A. DESCRIPTION OF ORIGINAL MONUMENT AND ACCESSORIES AND/OR SUBSEQUENT RESTORATION:

G.L.O. Not set.

Delos G. Anderson (County Surveyor)
Book A Pages 289 and 290 January 29, 1900
Found old corner and witness of Government Survey of Section 5.

William M. Jacques (County Surveyor)
Book 21 Page 84 1906
24" Pine N55°E 38 Links (25.08') #1
7" Pine N42°W 5 Links (3.30') #2

Newaygo Engineering and Survey Company
March 24, 1977 Drawing Number 77004AC
Found 3/4" Pipe
South One Quarter Corner, Section 32, T15N R12W,
West 11.86' (3/4" Pipe) #3
Power Pole S47°E 31.22' #4
16" Black Oak N42°W 89.36' #5
White Oak S45°W 82.02' #6

Ralph A. Smith R.L.S. #3421
Field Book 88 Pages 25 and 26 October 1963
Survey of North One Half of the Northeast Quarter of Section 5
Measured 11.90 feet between the South One Quarter Corner, Section 32, Monroe Township and the North One Quarter Corner Section 5, Wilcox Township

OVER ↵

B. DESCRIPTION OF CORNER EVIDENCE FOUND AND/OR METHOD APPLIED IN RESTORING OR REESTABLISHING CORNER:

Found 3/4" Pinch Pipe 11 1/2" long. The centerline of the North and South gravel road is 9 feet West and the centerline of the Northeasterly road is 18 feet North and the centerline of road going West is 15 feet South. The condition of the recorded witnesses are: #1 and #2 gone, #3 thru #7 good condition, #8 new pole. #9 good condition.

C. DESCRIPTION OF MONUMENT FOR CORNER AND ACCESSORIES ESTABLISHED TO PERPETUATE LOCATING THE POSITION OF THE CORNER:


Removed 3/4" Pinch Pipe and set a 4" diameter Harrison cast iron monument 20" long marked "County Surveyor" as a substantial marker for the section corner and is accepted as a careful and faithful reestablishment of the original corner.

South One Quarter Corner, Section 32, T15N R12W, 3/4" Pipe West 11.85' #3
Power Pole S47°E 31.18' Found spike in Northeast side of pole. #4
30" Black Oak N40°W 89.28' Found spike in South side of tree, set new spike and tag above it. #5
20" White Oak S45°W 81.80' Found spike in Northwest side of tree. #6
18" White Oak N50°E 89.03' Found spike in West side of tree. #7
Power Pole S53°W 69.43' to face.
28" Black Oak N33°E 103.28' Found nail and tag #30389 in West side of tree. #9

Signed by Norman L. Ochs Date October 13, 1997

Surveyor's Michigan License No. 22439

Form approved by Michigan State Board of Land Surveyors

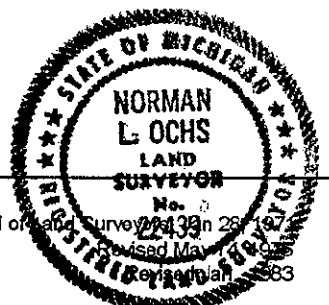

Approved by Peer Review Group on December 18, 1997
Norman L. Ochs, County Representative.

NLO

A. Description (cont.)

Carl P. Englert, Jr. R.L.S. #18987

1" Iron Pipe May 16, 1994

Recorded in Liber 360 Page 5889

Power Pole S45°E 31.25' #4

14" Oak N55°E 89.0' #7

26" Oak N40°W 89.20' #5

Power Pole S45°W 69.45' #8

William Fries, Jr. R.L.S. #30389

July 29, 1996 Pipe

24" Oak N28°E 103.29' #9

Power Pole S50°E 31.21' #4

13" White Oak S42°W 81.84' #6

27" Oak N45°W 89.33' #5