

**SURVEY &
REMONUMENTATION**

MAR 19 1998

1997 Newaygo County Remonumentation Project

NEWAYGO COUNTY
REGISTER OF DEEDS
LINDA M. BROWN

SECTION

**LAND CORNER RECORDATION CERTIFICATE
FILING REQUIREMENT of Act 74, Mich. P.A. 1970**

'98 MAR 6 PM 12 37

Linda M. Brown

For corners in <u>Newaygo</u> (County)	Located in:	Corner Code #
1. Public Land Survey	T <u>14N</u> R <u>12W</u>	<u>D-3</u>
	T ___ R ___	_____
	T ___ R ___	_____
	T ___ R ___	_____
2. Property Controlling in Section	S ___ T ___ R ___	_____
	S ___ T ___ R ___	_____
3. Miscellaneous Property in Sec.	S ___ T ___ R ___	_____
	S ___ T ___ R ___	_____
4. Lot No. _____, Recorded Plat _____		
5. Private Claims _____		

VOL. 2

111

Register of Deeds Stamp & File Number

	A	B	C	D	E	F	G	H	I	J	K	L	M
1													
2	6		5		4		3		2		1		
3			●										
4	7		8		9		10		11		12		
5													
6	18		17		16		15		14		13		
7													
8	19		20		21		22		23		24		
9													
10	30		29		28		27		26		25		
11													
12	31		32		33		34		35		36		
13													

I, Norman L. Ochs, in a field survey on October 9, 1997, do hereby certify that under requirements of P. A. 74, Michigan P.A. of 1970, the corner points mentioned in lines 1 and 2 above were in conformance with regulations and rules therefore as required in the current manual of survey instructions of the United States Department of the Interior, Bureau of Land Management or by a decree of a Court of Law and/or that the corner points mentioned in lines 3, 4 and 5 above were in conformance with the rules of the Michigan Board of Land Surveyors or by a Decree of a Court of Law; established, re-established, monumented, re-monumented, recovered, found as expressed below.

Note: Not more than 4 corners, all in the same town and range, may be recorded on this certificate.

South One Quarter Corner, Section 5, Wilcox Township, Newaygo County, Michigan.

A. DESCRIPTION OF ORIGINAL MONUMENT AND ACCESSORIES AND/OR SUBSEQUENT RESTORATION:

G.L.O. J.H. Mullett 1837
6" White Oak N71°W 27 Links (17.82')#1
12" Beech S14°E 22 Links (14.52')#2

Delos G. Anderson (County Surveyor)
Book A Pages 289 and 290 January 29, 1900
36" Pine N73°E 69 Links (45.54')#3

Lyle Shepherd's Witness Book Number 1 Page 25
1935
12" Black Oak S24°15'E 39.3' #4
24" Pine Stump N74¼°E 45.5' #3

Ralph A. Smith R.L.S. #3421
1963 Witness Book Number 1 Page 25
Book 88 Pages 25 and 26 Set ¾" Pipe
18" Oak S24°15'E 39.3' #4
24" Pine Stump N74¼°E 45.5' #3
8" White Oak N40°E 34.2' #5

Newaygo County Road Commission Sheet
½" Bolt
6" Twin Oak East 46.0' #6
12" Oak S40°E 38.1' #7

OVER ↶

B. DESCRIPTION OF CORNER EVIDENCE FOUND AND/OR METHOD APPLIED IN RESTORING OR REESTABLISHING CORNER:

Found ¾" Pinch Pipe on woods line going West. The centerline of the North and South gravel road is 2 feet West. The condition of the recorded witnesses are: #1 and #2 gone, #3 and #4 stump, #5 gone, #6 good condition, #7 gone, #8 thru #11 good condition.

C. DESCRIPTION OF MONUMENT FOR CORNER AND ACCESSORIES ESTABLISHED TO PERPETUATE LOCATING THE POSITION OF THE CORNER:

Removed ¾" Pinch Pipe and set a 4" diameter Harrison cast iron monument 20" long marked "County Surveyor" as a substantial marker for the section corner and is accepted as a careful and faithful reestablishment of the original corner.

- 36" Pine Stump N76°E 45.05' to face. #3
- 28" Stump S22°E 39.3' to face. #4
- 16" White Oak East 45.95' Found spike in South side of tree. #6
- 12"-12" Twin Maple N36°W 49.42' Set spike and tag in Southwest side of tree. #8
- 34" Red Oak N77°W 67.32' Set spike and tag over found spike. #9
- 28" Beech S34°E 70.02' Found nail in root. #10
- 12"-8" Twin White Oak S40°W 36.15' Found spike in Northwest side of tree. #11

Signed by Norman L. Ochs
Norman L. Ochs


Date October 13, 1997

Surveyor's Michigan License No. 22439

Form approved by Michigan State Board of Land Surveyors, Jan 28, 1971
Revised May 14, 1975
Revised Jan., 1983

Approved by Peer Review Group on October 14, 1997
Norman L. Ochs, County Representative.

N.L.O.

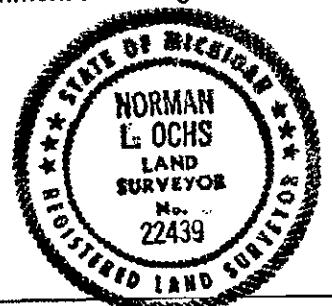

A. Description (cont.)

Newaygo Engineering and Survey Company
August 16, 1977 Drawing Number 77004AC
Found ¾" Pipe
White Oak S87°E 46.0' #6
8"-8" Twin Maple N38°W 49.42' #8
18" Red Oak N78°W 67.32' #9

William Fries, Jr. R.L.S. #30389
LCRC #843 November 7, 1987
Found 1¼" outside diameter Pipe
14" White Oak East 45.95' #6
19" Beech S37°E 69.98' #10
23" Oak N82°W 66.51' #9
10" Double Maple N42°W 49.39' #8

Newaygo Engineering and Survey Company
September 29, 1989 Drawing Number 88235B
Found ¾" Pipe
14" White Oak East 45.98' #6
20" Beech S40°E 69.96' #10
26" Red Oak N80°W 67.31' #9
6"-10" Twin White Oak S40°W 36.15' #11

William Fries, Jr. R.L.S. #30389
May 11, 1991 Recorded in Liber 352 Page 5700
Found 1¼" outside diameter Pipe
Witnesses same as LCRC #843 in 1987.