

MAR 02 1999

1998 Newaygo County Remonumentation Project

NEWAYGO COUNTY REGISTER OF DEEDS LINDA M. BROWN

'99 FEB 17 PM 3 42

SECTION

LAND CORNER RECORDATION CERTIFICATE FILING REQUIREMENT of Act 74, Mich. P.A. 1970

Linda M. Brown

For corners in <u>Newaygo</u> (County)	Located in:	Corner Code #
1. Public Land Survey	T <u>14N</u> R <u>12W</u>	<u>K-12</u>
	T ___ R ___	_____
	T ___ R ___	_____
	T ___ R ___	_____
2. Property Controlling in Section	S ___ T ___ R ___	_____
	S ___ T ___ R ___	_____
3. Miscellaneous Property in Sec.	S ___ T ___ R ___	_____
	S ___ T ___ R ___	_____
4. Lot No. _____, Recorded Plat _____		
5. Private Claims _____		

VOL. 2

261

Register of Deeds Stamp & File Number

	A	B	C	D	E	F	G	H	I	J	K	L	M
1													
2	6	5	4	3	2	1							
3													
4	7	8	9	10	11	12							
5													
6	18	17	16	15	14	13							
7													
8	19	20	21	22	23	24							
9													
10	30	29	28	27	26	25							
11													
12	31	32	33	34	35	36							
13													

I, Norman L. Ochs, in a field survey on January 7, 1998, do hereby certify that under requirements of P. A. 74, Michigan P.A. of 1970, the corner points mentioned in lines 1 and 2 above were in conformance with regulations and rules therefore as required in the current manual of survey instructions of the United States Department of the Interior, Bureau of Land Management or by a decree of a Court of Law and/or that the corner points mentioned in lines 3, 4 and 5 above were in conformance with the rules of the Michigan Board of Land Surveyors or by a Decree of a Court of Law; established, re-established, monumented, re-monumented, recovered, found as expressed below:

Note: Not more than 4 corners, all in the same town and range, may be recorded on this certificate.

West One Quarter Corner, Section 36, Everett Township, Newaygo County, Michigan.

A. DESCRIPTION OF ORIGINAL MONUMENT AND ACCESSORIES AND/OR SUBSEQUENT RESTORATION:

G.L.O. J.H. Mullett 1837
12" Pine N88°W 17 Links (11.22')#1
8" Hemlock S79°E 18 Links (11.88')#2

Jack E. Pierson R.L.S. #19305
April 1981 File Number SAL-063-81
Set 1/2" Rebar
North and South Fence is 6 feet ± East
8" Maple N84°W 14.29' #3
4" Maple N10°W 15.84' #4
4" Maple S73°E 8.61' #5

B. DESCRIPTION OF CORNER EVIDENCE FOUND AND/OR METHOD APPLIED IN RESTORING OR REESTABLISHING CORNER:

Found 1/2" Rerod and cap #19305 next to a 1 1/4" inside diameter Guard Pipe sticking 2 feet out the ground.. Remains of East and West fence found 4 feet ± North of the 1/2" Rerod and cap. The condition of the recorded witnesses are: #1 and #2 gone, #3 thru #5 good condition.

C. DESCRIPTION OF MONUMENT FOR CORNER AND ACCESSORIES ESTABLISHED TO PERPETUATE LOCATING THE POSITION OF THE CORNER:

Removed Rerod and Pipe and set a 4" diameter Harrison cast iron monument 30" long marked "County Surveyor" as a substantial marker for the section corner and is accepted as a careful and faithful reestablishment of the original corner.


12" Maple S82°W 14.30' #3
6" Maple N17°W 15.88' #4
5" Maple S50°E 8.66' #5
12" White Pine N52°E 34.72'

Signed by *Norman L. Ochs* Date November 5, 1998
Norman L. Ochs

Surveyor's Michigan License No. 22439 Form approved by Michigan State Board of Land Surveyors, Jan 28, 1971

Approved by Peer Review Group on November 10, 1998
Norman L. Ochs, County Representative.

Revised May 14, 1975
Revised Jan., 1983

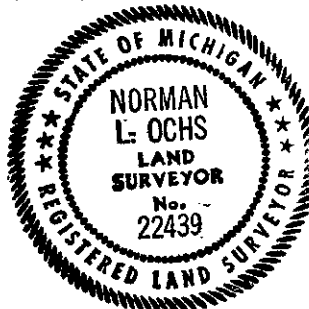

N.L.O.