

MAR 08 1999

1998 Newaygo County Remonumentation Project

NEWAYGO COUNTY REGISTER OF DEEDS LINDA M. BROWN

'99 FEB 17 PM 3 42

SECTION

LAND CORNER RECORDATION CERTIFICATE FILING REQUIREMENT of Act 74, Mich. P.A. 1970

Linda M. Brown

For corners in Newaygo (County)

Located in:

Corner Code #

- 1. Public Land Survey T 14N R 12W K-13
2. Property Controlling in Section S T R
3. Miscellaneous Property in Sec. S T R
4. Lot No. Recorded Plat
5. Private Claims

VOL. 2 262

Register of Deeds Stamp & File Number

Grid table with columns A-M and rows 1-13. Cell (2,6) contains '6', (2,5) contains '5', (2,4) contains '4', (2,3) contains '3', (2,2) contains '2', (2,1) contains '1'.

I, Norman L. Ochs, in a field survey on October 26, 1998, do hereby certify that under requirements of P. A. 74, Michigan P.A. of 1970, the corner points mentioned in lines 1 and 2 above were in conformance with regulations and rules therefore as required in the current manual of survey instructions of the United States Department of the Interior, Bureau of Land Management or by a decree of a Court of Law and/or that the corner points mentioned in lines 3, 4 and 5 above were in conformance with the rules of the Michigan Board of Land Surveyors or by a Decree of a Court of Law; established, re-established, monumented, re-monumented, recovered, found as expressed below.

Note: Not more than 4 corners, all in the same town and range, may be recorded on this certificate.

Southwest Corner, Section 36, Everett Township, Newaygo County, Michigan.

A. DESCRIPTION OF ORIGINAL MONUMENT AND ACCESSORIES AND/OR SUBSEQUENT RESTORATION:

G.L.O. John Hodgson 1837
8" Elm N72°E 34 Links (22.44')#1
8" Black Ash N04¼°W 8 Links (5.28')#2
Set Post, Northwest Corner, Section 1, T13N R12W, West 18 Links (11.88')#6

Norman L. Ochs R.L.S. #22439
July 31, 1980 Set a ½" Rod and cap on line between the Northwest Corner and the North One Quarter Corner of Section 1, T13N R12W, East 11.88 feet (18 Links) of the Northwest Corner of said Section 1, per G.L.O.
28" White Oak S07°E 81.27' #3
14" - 12" Twin Basswood N68°W 77.19' #4
10" - 12" Clump Basswood N38°E 59.11' #5
Northwest Corner, Section 1, T13N R12W, West (18 Links) 11.88' #6

B. DESCRIPTION OF CORNER EVIDENCE FOUND AND/OR METHOD APPLIED IN RESTORING OR REESTABLISHING CORNER:

Found ¾" X 8" Iron Pipe over a ¾" X 24" Rerod next to a ¾" X 24" Rerod on line ± with the centerline of the East and West bituminous road. There is no obvious occupation going North. The condition of the recorded witnesses are: #1 and #2 gone, #3 good condition, #4 and #5 gone, #6 good condition.

C. DESCRIPTION OF MONUMENT FOR CORNER AND ACCESSORIES ESTABLISHED TO PERPETUATE LOCATING THE POSITION OF THE CORNER:

Removed Iron Pipe and Rerod and set a 2¾" X 20" Harrison cast iron monument marked "County Survey" in a new 8" diameter monument box as a substantial marker for the section corner and is accepted as a careful and faithful reestablishment of the original corner.

36" White Oak S10°E 82.54' Found spike in West side of tree. #3
Northwest Corner, Section 1, T13N R12W, West 11.79' #6
12" Maple N09°E 66.27' Set spike with tag #22439 in West side of tree
10" White Pine S38°W 68.97' Set spike with tag #22439 in Northwesterly side of tree.
10" Hemlock (blazed) N60°W 94.42' Set spike with tag #22439 in South side of tree.

Signed by Norman L. Ochs Date November 3, 1998


Surveyor's Michigan License No. 22439

Form approved by Michigan State Board of Land Surveyors 1971

Approved by Peer Review Group on December 8, 1998

Revised May 14, 1975 Revised Jan., 1983

Norman L. Ochs, County Representative.

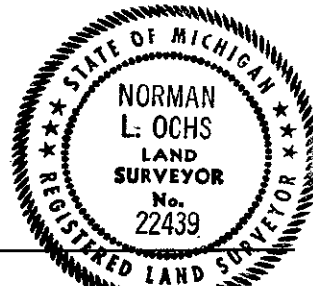

M.L.O.